

Service No.

Name

Address # 42 Sanderson Road

Location

42 Sanderson Road

Size of Main 8"

Size 6"

Location


Repair—Renewal—New Service

Date	Material	Amount	Total	Date	Amount
5/25	76 30'-6" H.C.P.				
6/3	76 30'-6" H.C.P.				
	10'-9" C.I.				

DATE _____

TOWN OF LEXINGTON — BOARD OF PUBLIC WORKS
SEWER DIVISION

Sketch of Service Here **42**

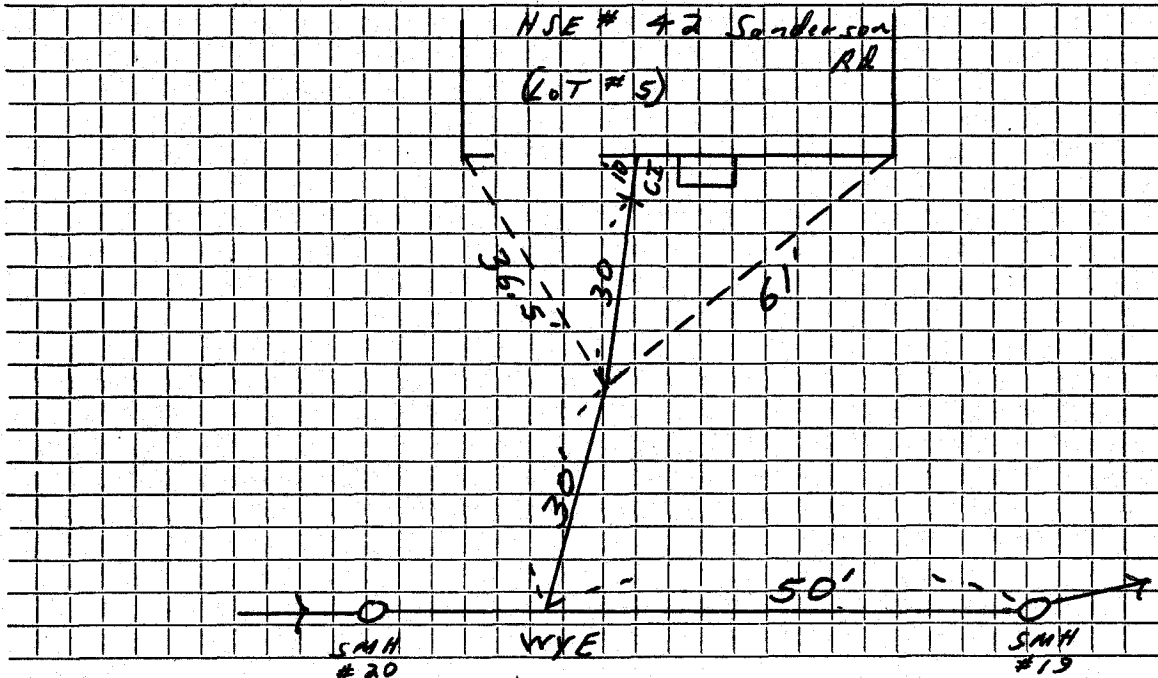

Connection made in Sanderson Road Street. Work completed

Remarks:
.....
.....