

DATE

TOWN OF LEXINGTON — BOARD OF PUBLIC WORKS


SEWER DIVISION

Sketch of Service Here

43

HSE # 43 Sanderson Rd.

Act 7 1/2

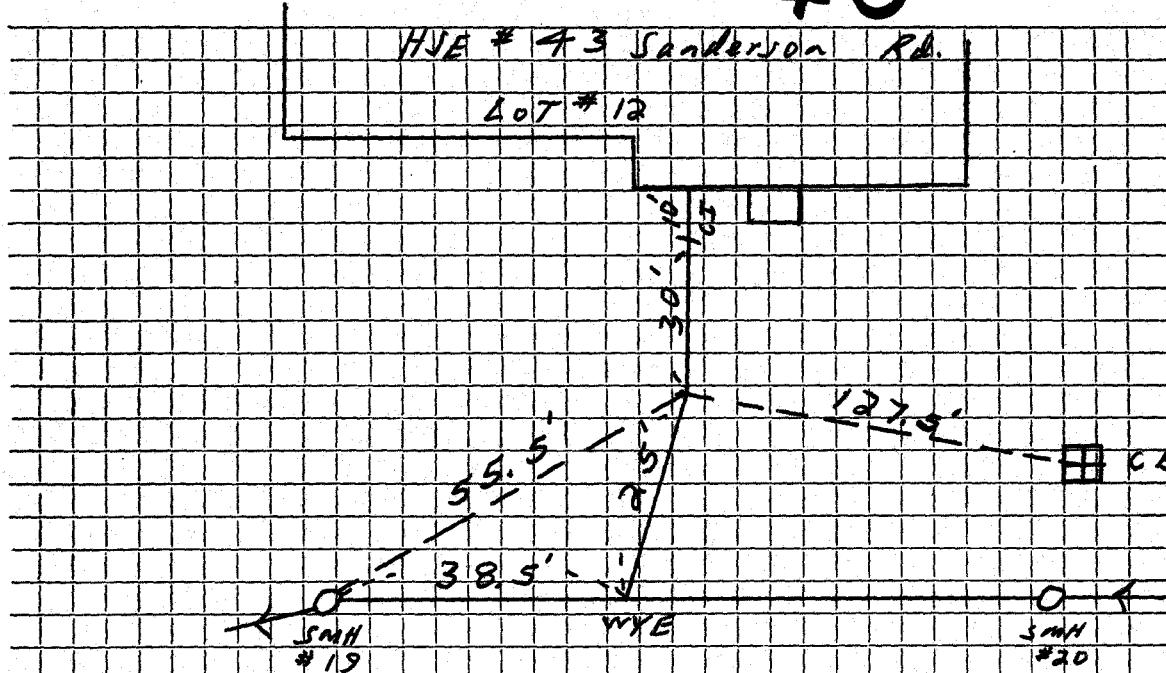

Connection made in Sanderson Road Street.

Work completed

Remarks: