

Name Paul Schimmel

Service No.

Address #44 SANDERSON RD

44 Sanderson Road

Location

Kind of Pipe PVC

Size 6"

Size of Main 8" ACP

~~Repair - Renewal~~ New Service Valeri #4091


Location

Date		Material	Amount	Total	Date		Amount
6/18/76	42'	6" ACP					
	10'	4" C.I.					
6/8/82	20'	6" ACP					
		REPAIR (Valeri)				OUTSIDE	
10/26/82	49' x	6" PVC			10/26/82	10' x 6" PVC	
	1	6" x 4" Donut				1 6" ACP x PVC Adaptor	

DATE 10-26-82

TOWN OF LEXINGTON — BOARD OF PUBLIC WORKS  
SEWER DIVISION

Sketch of Service Here **44**

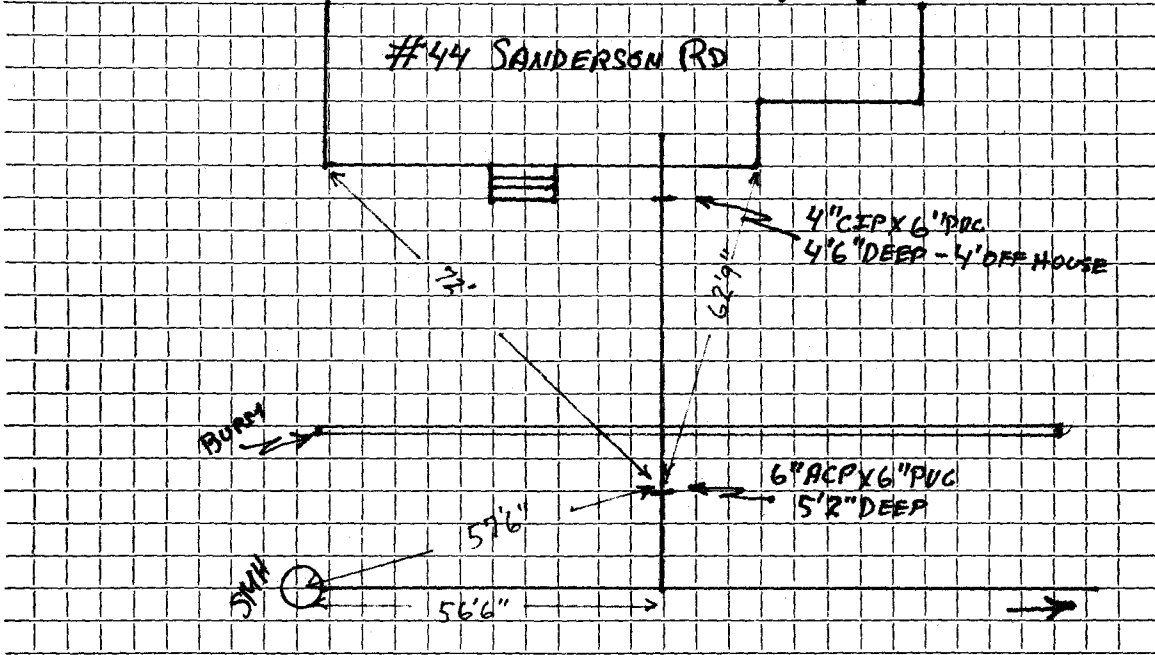

Connection made in SANDERSON RD Street. Work completed .....

Remarks: GROUND SETTLED AND SEWER PIPE REPAIRED WITH 59'6" X 6" PVC PIPE ON 10-26-82  
10' X 6" ACP PIPE IN STREET