

Service No.

Name

Address # 47 Sanderson Road

47 Sanderson Road

Location

Kind of Pipe

Size 6"

Size of Main 8"

Repair—Renewal—New Service


Location

Date	Material	Amount	Total	Date	Amount
5/27	76 30'-6" A.C.P.				
5/27	76 30'-6" A.C.P.				
	19'-4" C.I.				

DATE _____

TOWN OF LEXINGTON — BOARD OF PUBLIC WORKS
SEWER DIVISION

Sketch of Service Here **47**

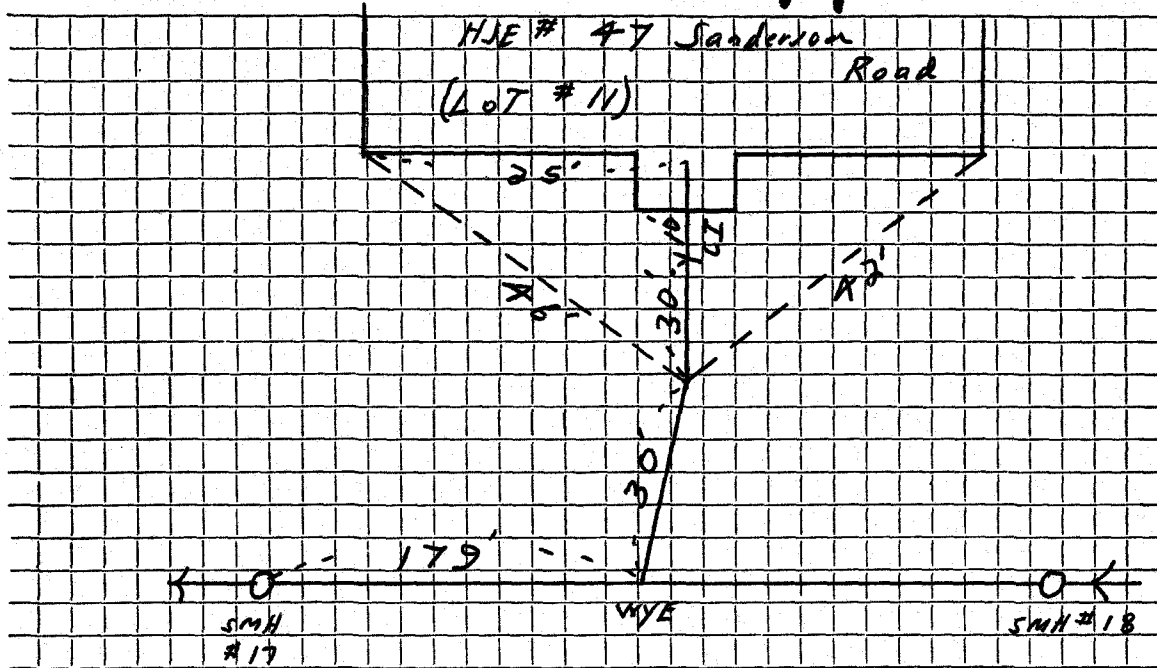

Connection made in Sanderson Road Street. Work completed

Remarks:

.....

.....