

Service No.

Name

Address # 48 Sanderson Road

Location

48 Sanderson Road

Kind of Pipe

Size 6"

Size of Main 8"

Location

Repair—Renewal—New Service

Date	Material	Amount	Total	Date	Amount
5/18 76	30'-6" A.C.P.				
5/18 76	25'-6" A.C.P.				
	10'-4" C.I.				


3-6-11002

DATE \_\_\_\_\_

TOWN OF LEXINGTON — BOARD OF PUBLIC WORKS

SEWER DIVISION

Sketch of Service Here **48**

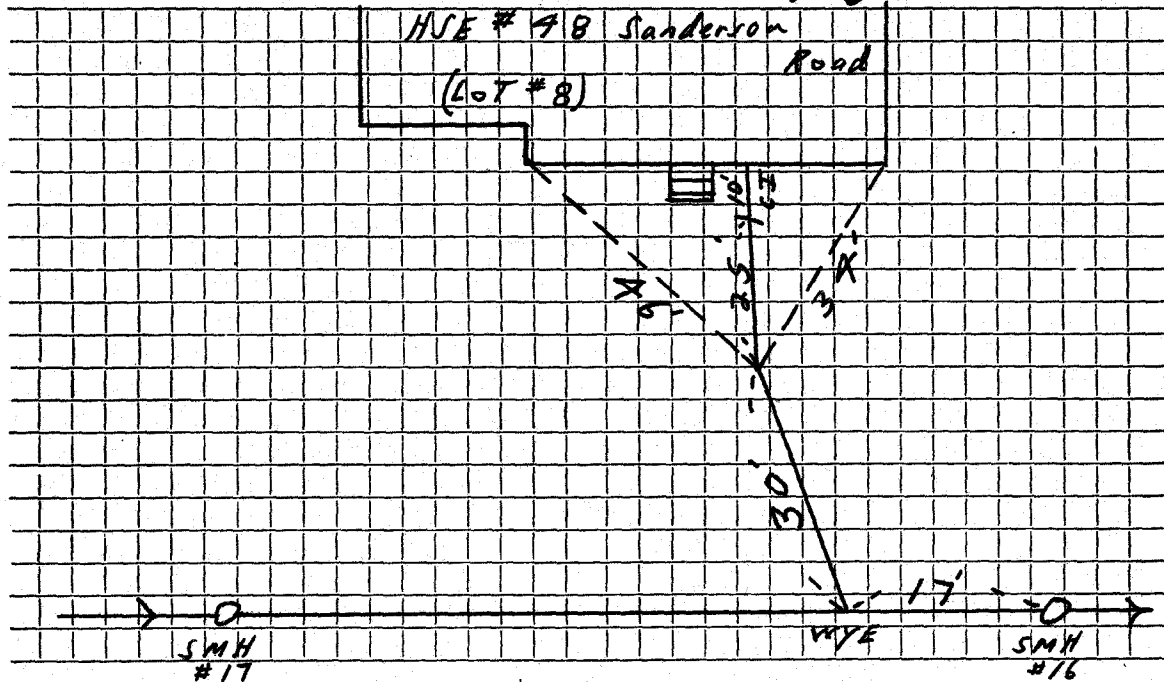

Connection made in Sanderson Road Street. Work completed .....

Remarks: .....  
.....  
.....