


DATE _____

TOWN OF LEXINGTON — BOARD OF PUBLIC WORKS
SEWER DIVISION

Sketch of Service Here **49**

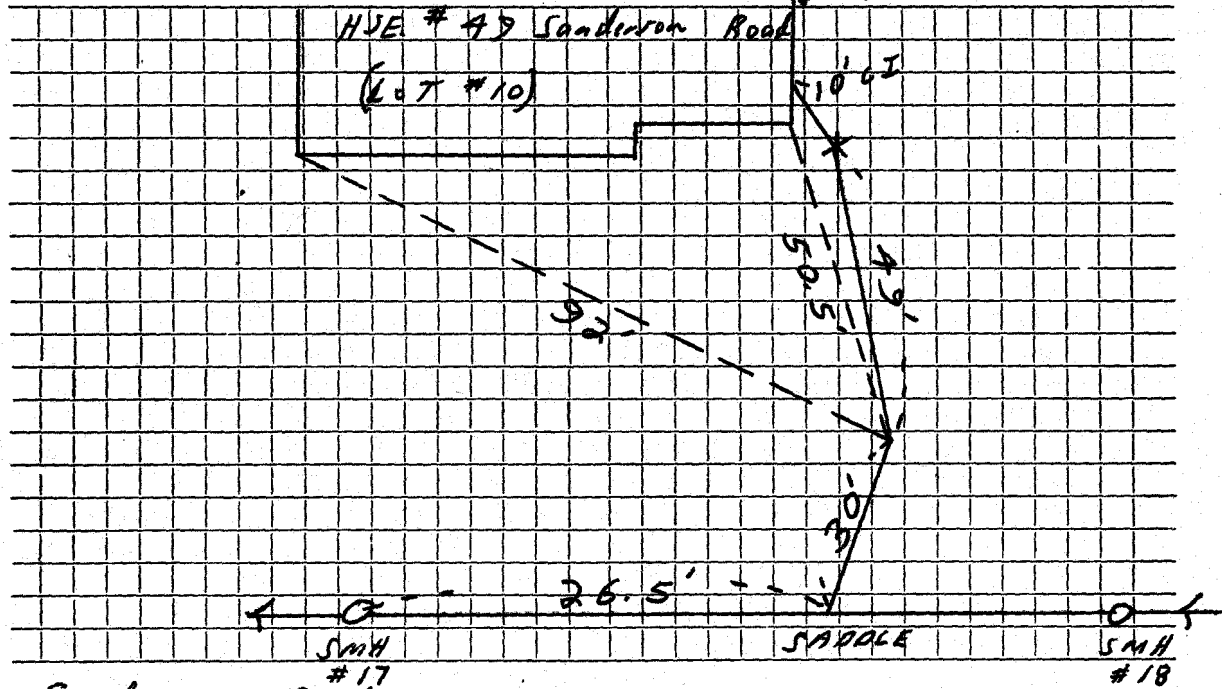

Connection made in Sanderson Road ~~Street~~ Work completed

Remarks:
.....
.....