

Name

Service No.

Address # 51 Sanderson Road

Location

51 Sanderson Road

Kind of Pipe

Size 6"

Size of Main 8"

Repair—Renewal—New Service

Location


Date	Material	Amount	Total	Date	Amount
5/17	76 20' - 6" A.C.P.				
5/17	76 36' - 6" A.C.P.				
	10' - 9" C.I.				

DATE _____

TOWN OF LEXINGTON — BOARD OF PUBLIC WORKS
SEWER DIVISION

Sketch of Service Here

51

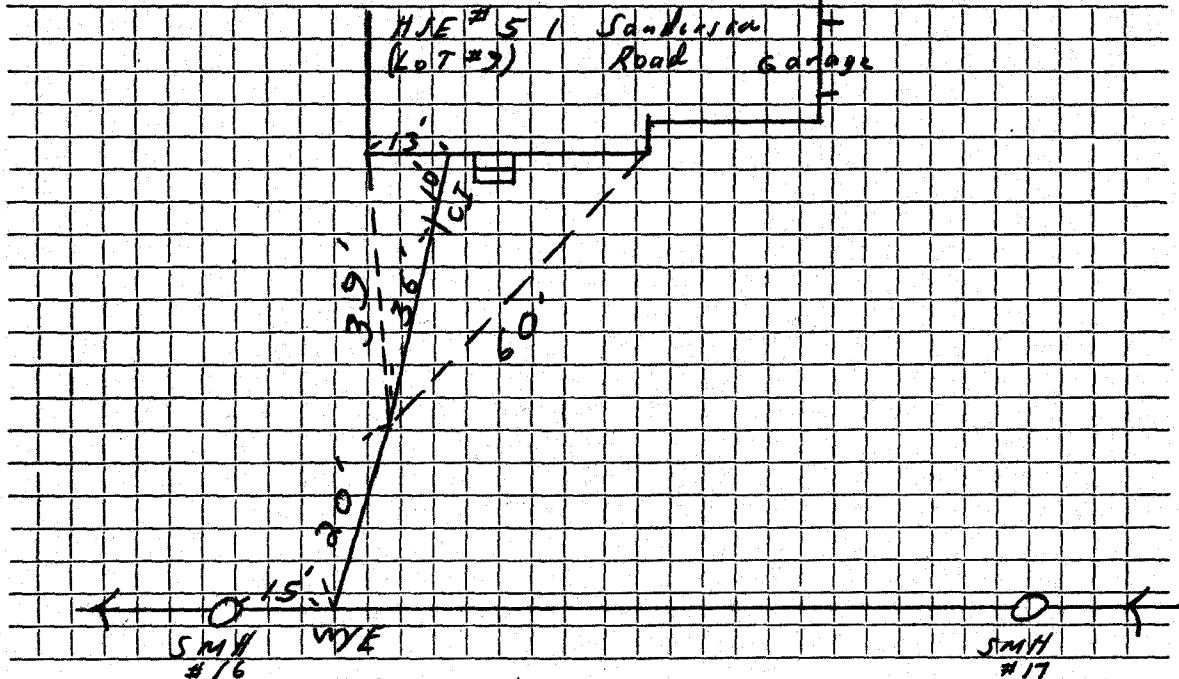

Connection made in .. Sanderson .. Road .. Street.

Work completed

Remarks: