


DATE _____

TOWN OF LEXINGTON — BOARD OF PUBLIC WORKS

SEWER DIVISION

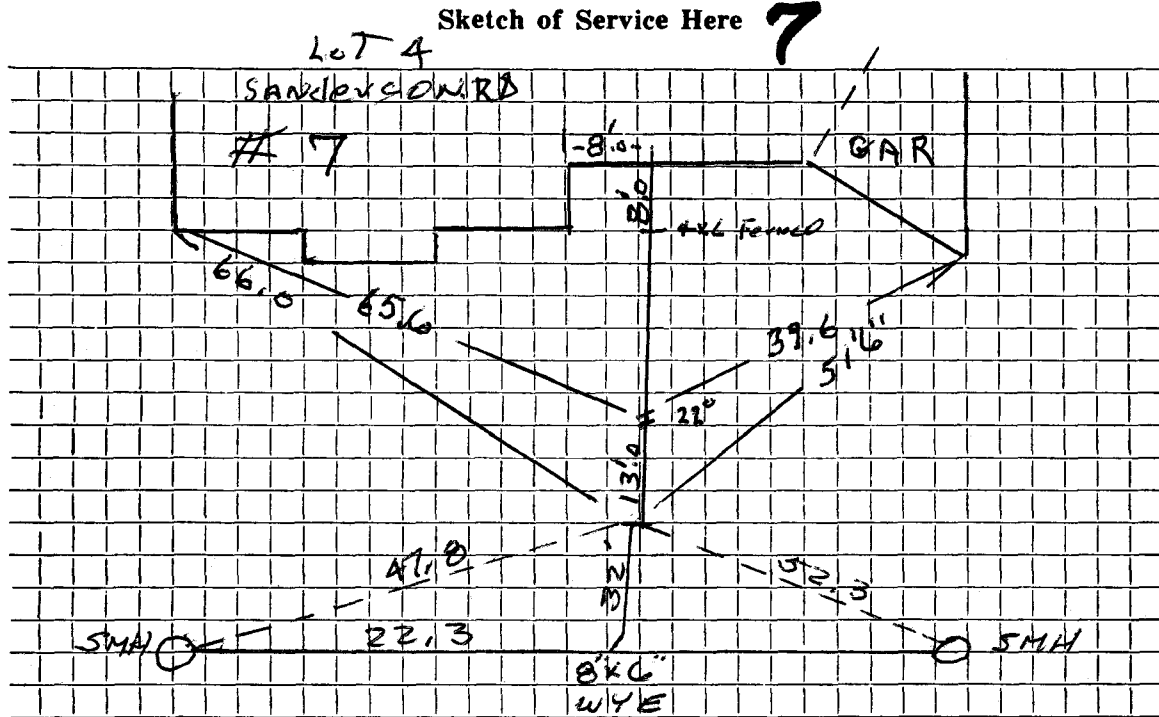

Connection made in SANDERSON RD Street.

Work completed 7/17/95 J. McLaughlin

Remarks:

.....

.....