

Name *Shiau Chin*

Service No.

Address 8 Sanderson Road

8 Sanderson Road

Location

Kind of Pipe PVC

Size 6 "

Size of Main 8"

Repair—Renewal—New Service

Redmond #0009

Location

DATE 10-3-'89


TOWN OF LEXINGTON — BOARD OF PUBLIC WORKS

SEWER DIVISION

Sketch of Service Here

8

#8 SANDERSON Road

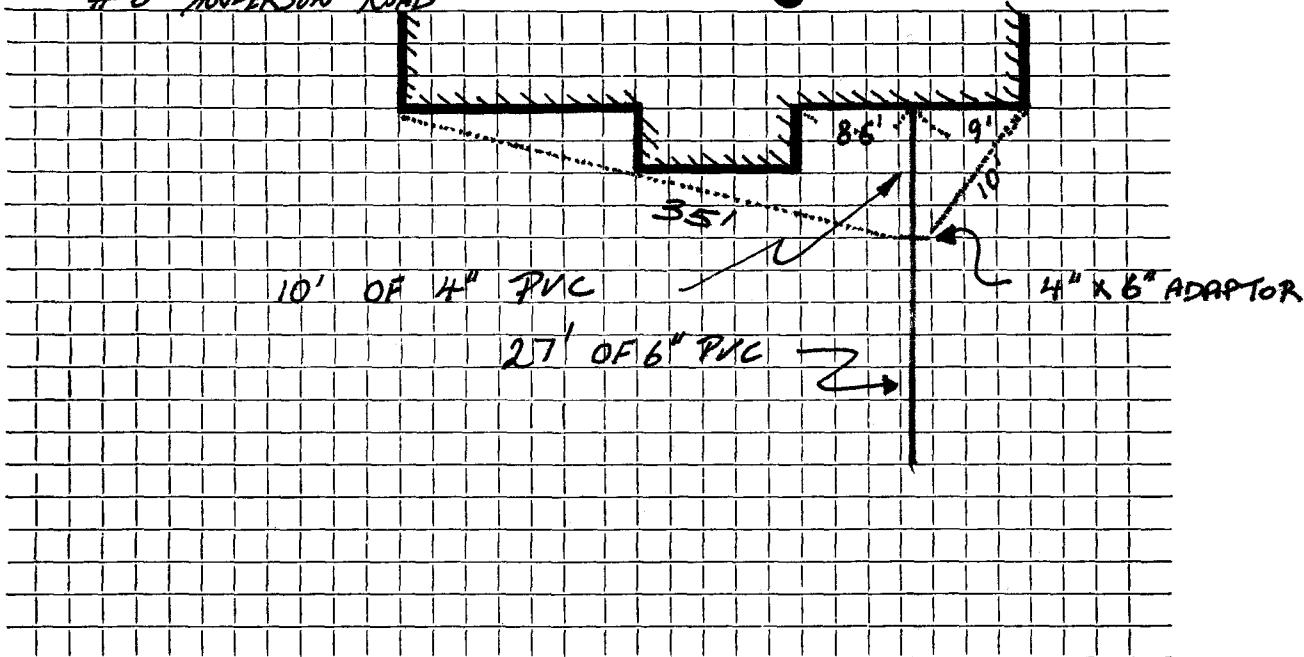

Connection made in ... SANDERSON ROAD Work completed

Remarks: ... INSPECTED 10 - 3 - '89 BY ... MB, INSTALLED BY J. REDMOND