


DATE 1/15/19

TOWN OF LEXINGTON — BOARD OF PUBLIC WORKS
SEWER DIVISION

Sketch of Service Here

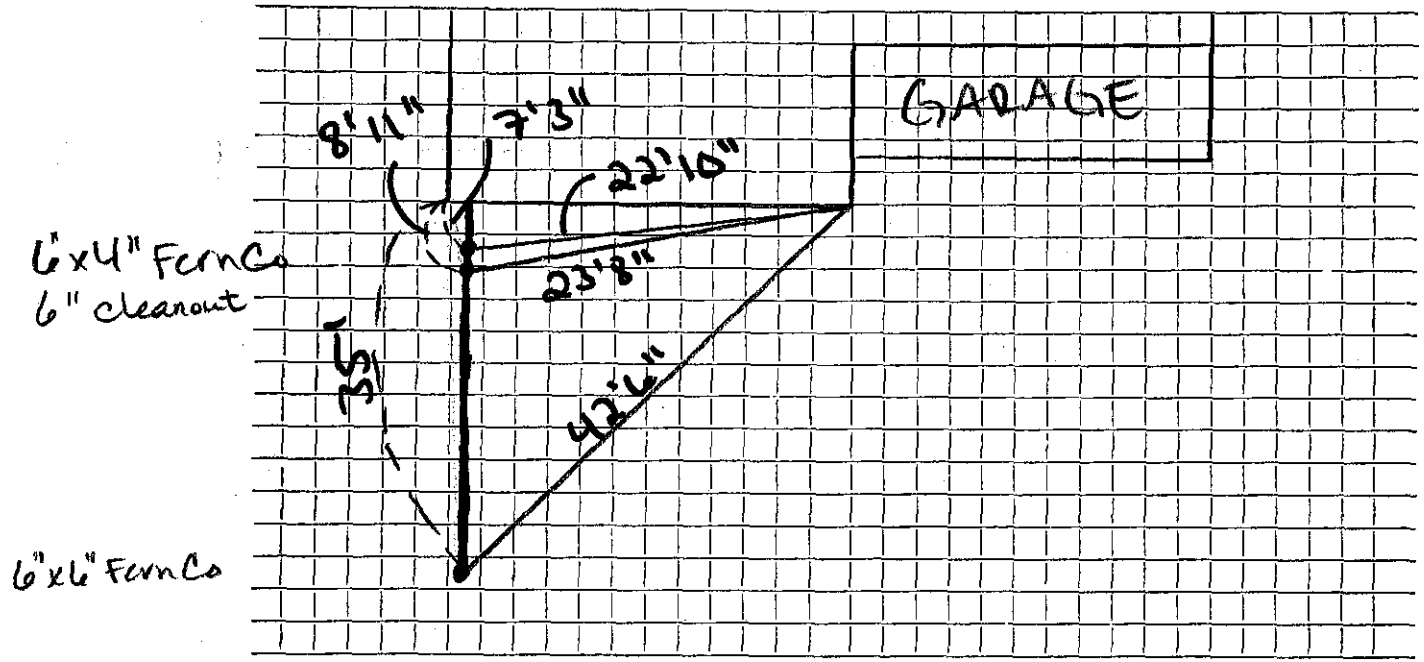

Connection made in School Street. Work completed

Remarks:
.....
.....