


DATE _____

TOWN OF LEXINGTON — BOARD OF PUBLIC WORKS
SEWER DIVISION

Sketch of Service Here

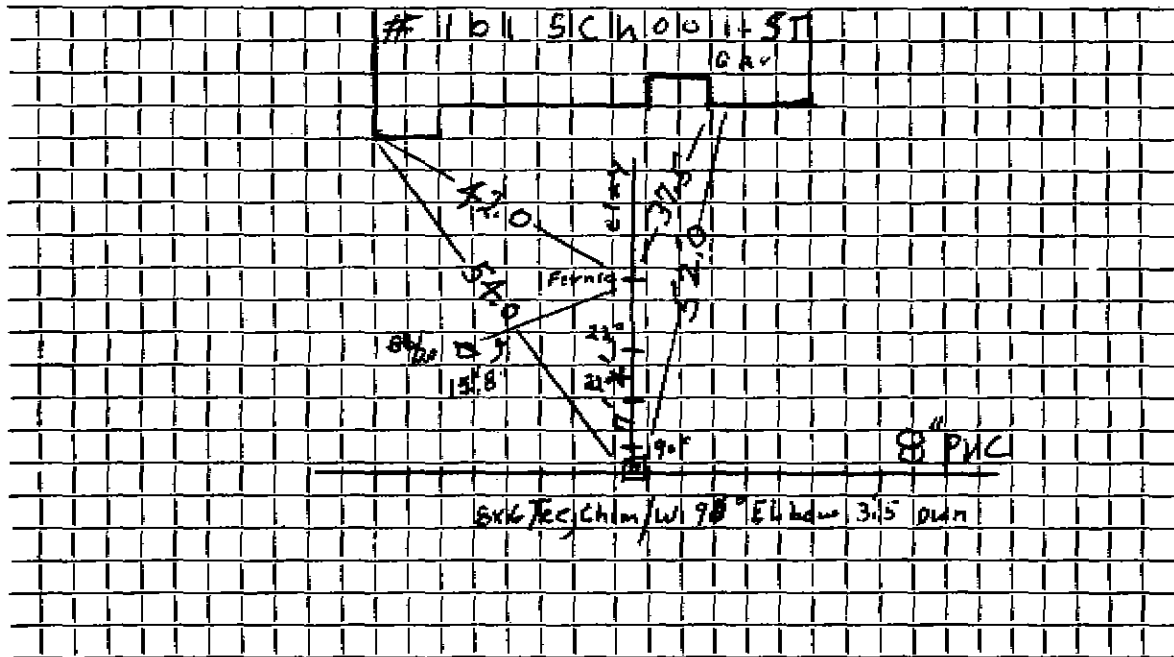

Connection made in Street. Work completed

Remarks: PVC Service goes under drain pipe IN gutter
1-22° bend 7' out from Chim. / 1-22° is 11' out from Chim