




DATE \_\_\_\_\_

**TOWN OF LEXINGTON — BOARD OF PUBLIC WORKS**  
**SEWER DIVISION**

Sketch of Service Here

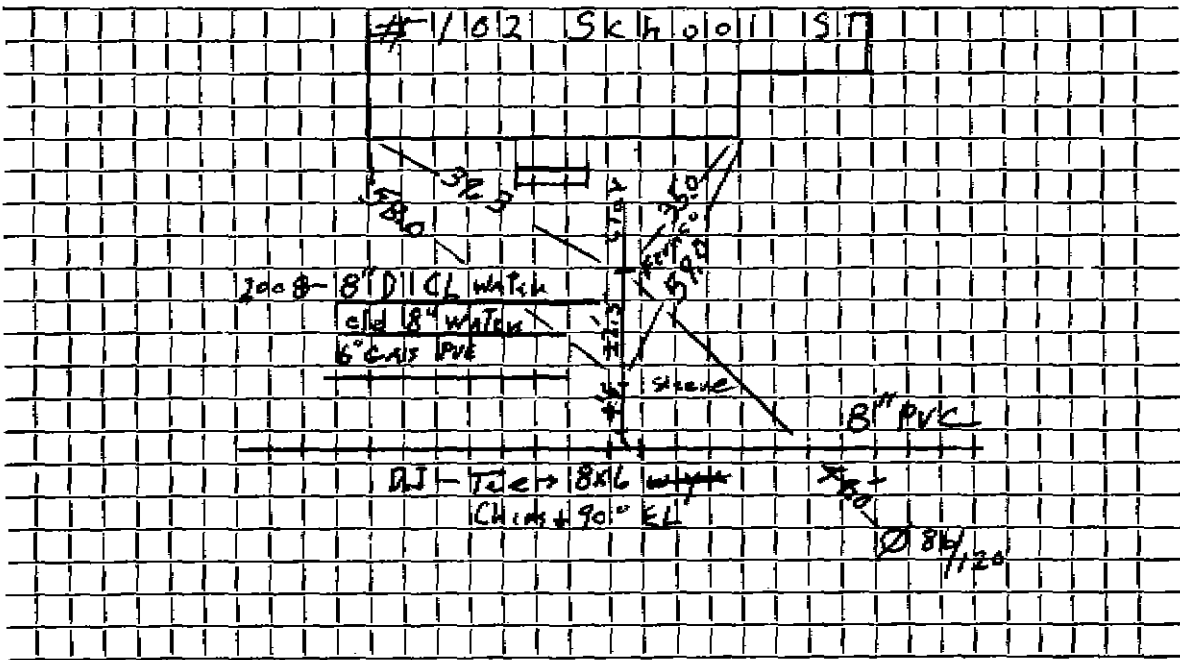

Connection made in ..... Street. Work completed 9/8/08 Address S. - W. Sp. Manny

Remarks: 6" PVC service under All Pipes ..... West. A. Samson