


DATE _____

TOWN OF LEXINGTON — BOARD OF PUBLIC WORKS
SEWER DIVISION

Sketch of Service Here

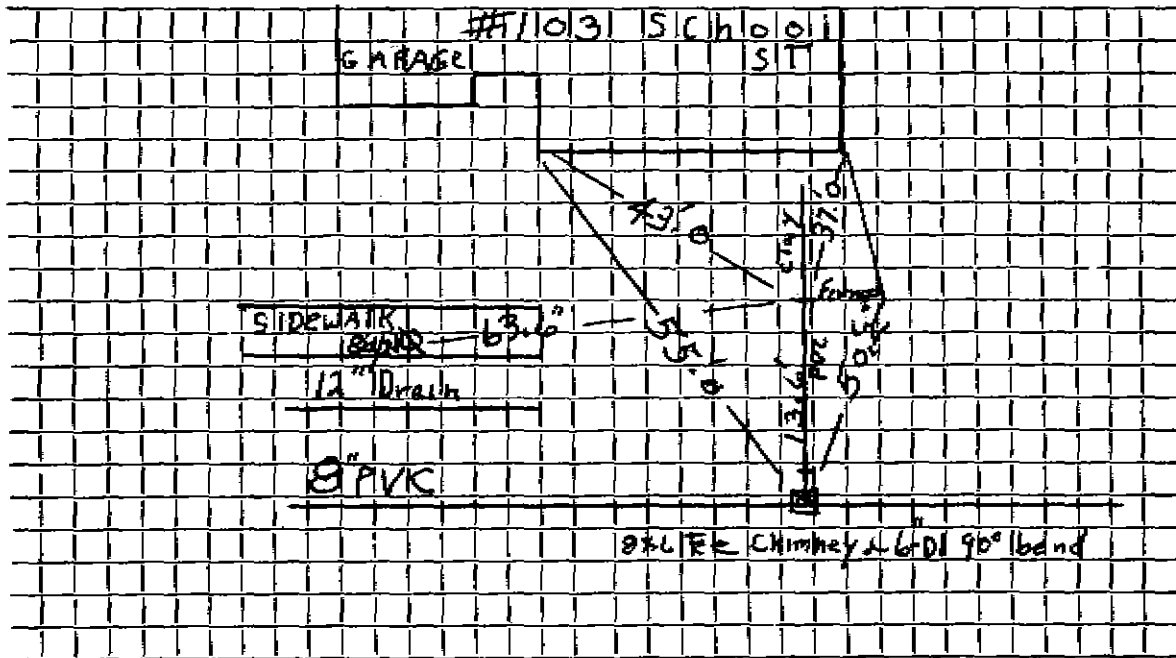

Connection made in Street. Work completed 10/3/08 Address:

Remarks: 6\" PVC goes under drain Pipe

.....
.....