




DATE \_\_\_\_\_

**TOWN OF LEXINGTON — BOARD OF PUBLIC WORKS**  
**SEWER DIVISION**

**109** Sketch of Service Here

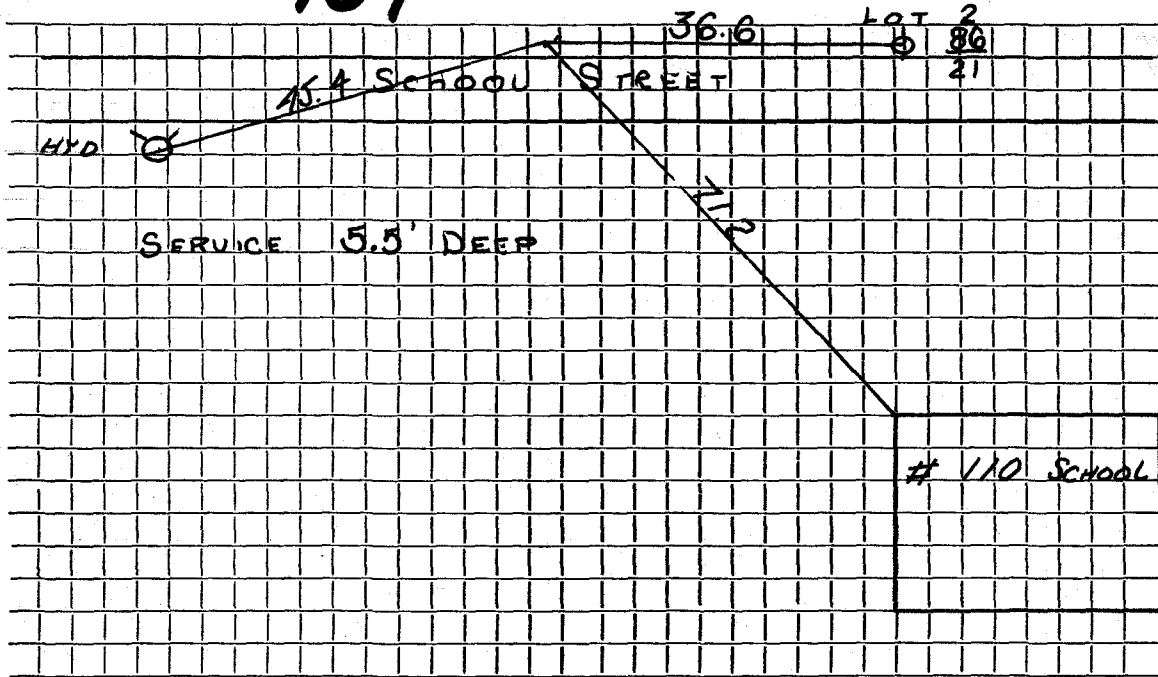

Connection made in ..... Street. Work completed .....

Remarks: .....  
.....  
.....