

Name

Service No.

Address 110 School St

Location

LOT 217

Kind of Pipe PVC + Clay

Size 6"

Size of Main 8" PVC

Repair—Renewal—New Service

Location


Date	Material	Amount	Total	Date	Amount
9/10/08	20' 6" PVC To GAS MAIN				
	4.5 1" PVC To Check				
	1 6" Sleeve, Clay x PVC For new @ 100'				
	1 8x6 Tee D.I				
	1 90° Elbow 2				
	1 Chimney 2				
5/24/55	EXIST 6" Clay Pipe To house				

DATE _____

TOWN OF LEXINGTON — BOARD OF PUBLIC WORKS

SEWER DIVISION

Sketch of Service Here

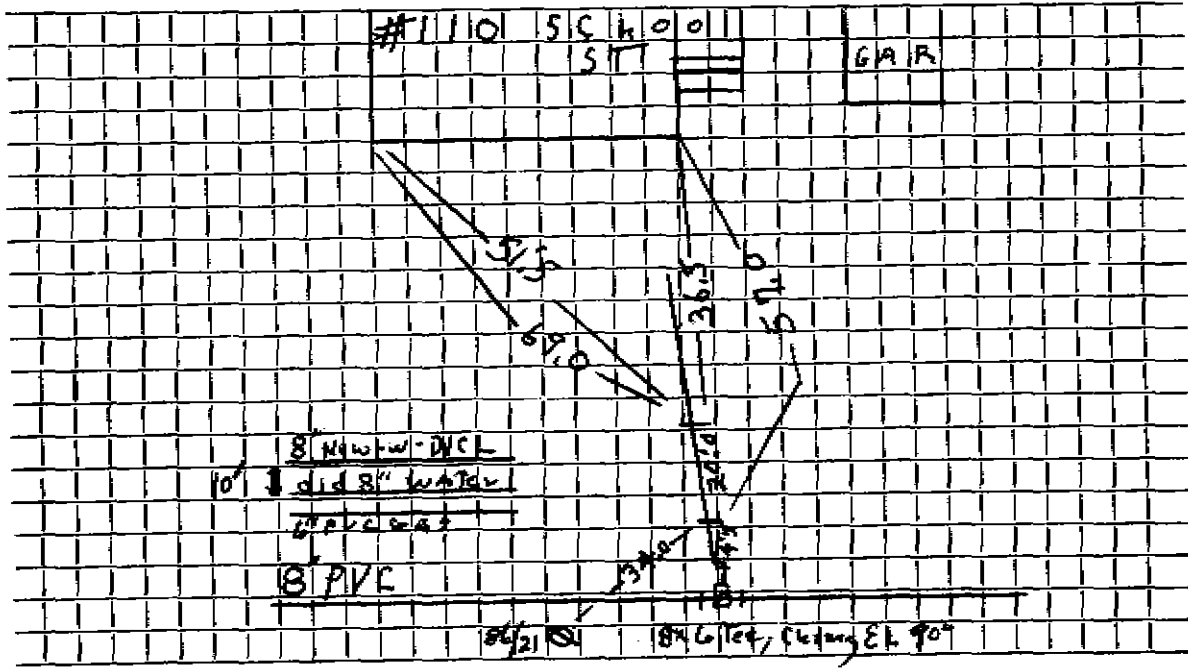

Connection made in _____ Street. Work completed Sept 10-08 Andreas

Remarks: Sewer Service goes under All Pipes
10' between 8" Water MAINS