

DATE _____


TOWN OF LEXINGTON — BOARD OF PUBLIC WORKS
SEWER DIVISION

115 SCHOOL STREET

Sketch of Service Here

115
TIES FOR LOT 1

$\frac{86}{23}$

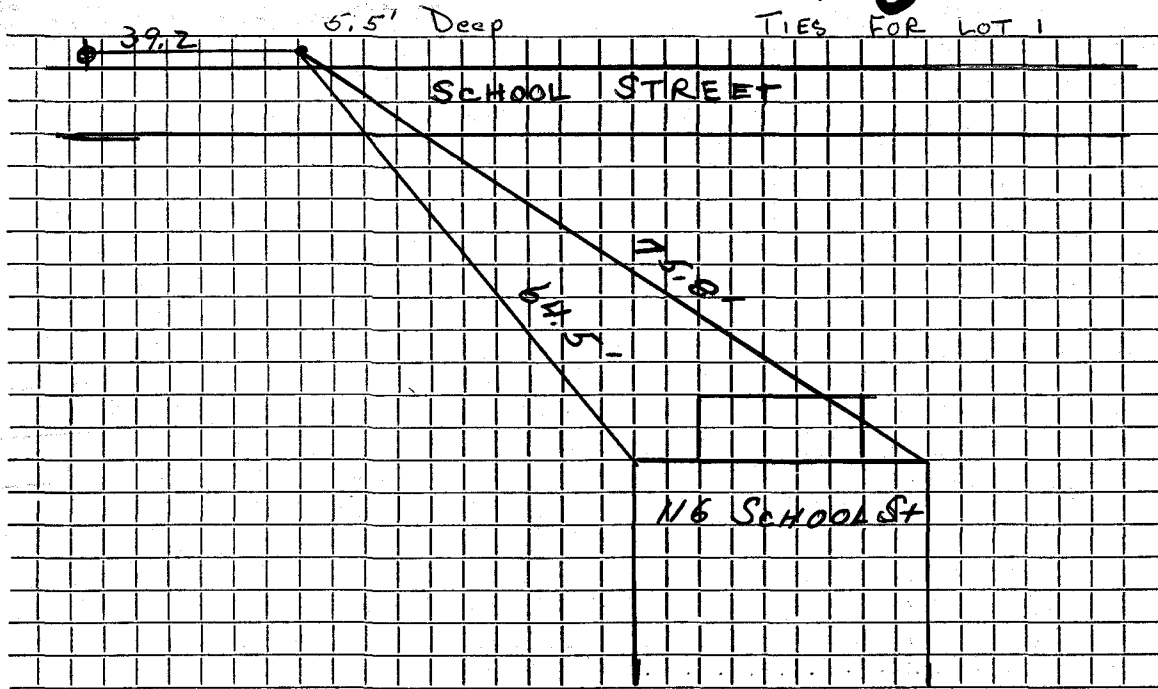

Connection made in Street. Work completed

Remarks:
.....
.....