

Name Moore Construction Inc.

Service No. 35

Address 120 School Street

120 School Street

Location

Kind of Pipe

Size 6"

Size of Main 8"

~~Repair~~ New Service

Location L 219
Comm 7-6-59


| Date | Material | Amount | Total | Date | Amount | |
|---------|----------------------------|--------|--------|----------|----------|--------|
| 5-25-59 | Labor | 87 67 | | 4-17-59 | Deposit | 300 00 |
| | 10% O. H. | 8 77 | 96 1/4 | 7-6-59 | Retained | 72 92 |
| 77' | 6" Sewer Pipe @.70 | | 53 90 | | | 207 08 |
| 1 | 11 1/2" Transite Elbow | | 2 24 | | | |
| 1/4 | Hrs. Town Shovel @6.50 | | 26 00 | | | |
| 2 | Hrs. Trucking @.75 | | 1 50 | | | |
| 1 | Hr. Rodgers Trailer @3.00 | | 3 00 | | | |
| 1 | Hr. Trucking @3.00 | | 3 00 | | | |
| | 21 x 3 Patch | | 21 00 | | | |
| | | | 207 08 | 12-29-75 | Solids | |
| | Service goes into Man hole | | | | | |
| | School ST ← | | | | | |

DATE _____

TOWN OF LEXINGTON — BOARD OF PUBLIC WORKS

SEWER DIVISION

Sketch of Service Here

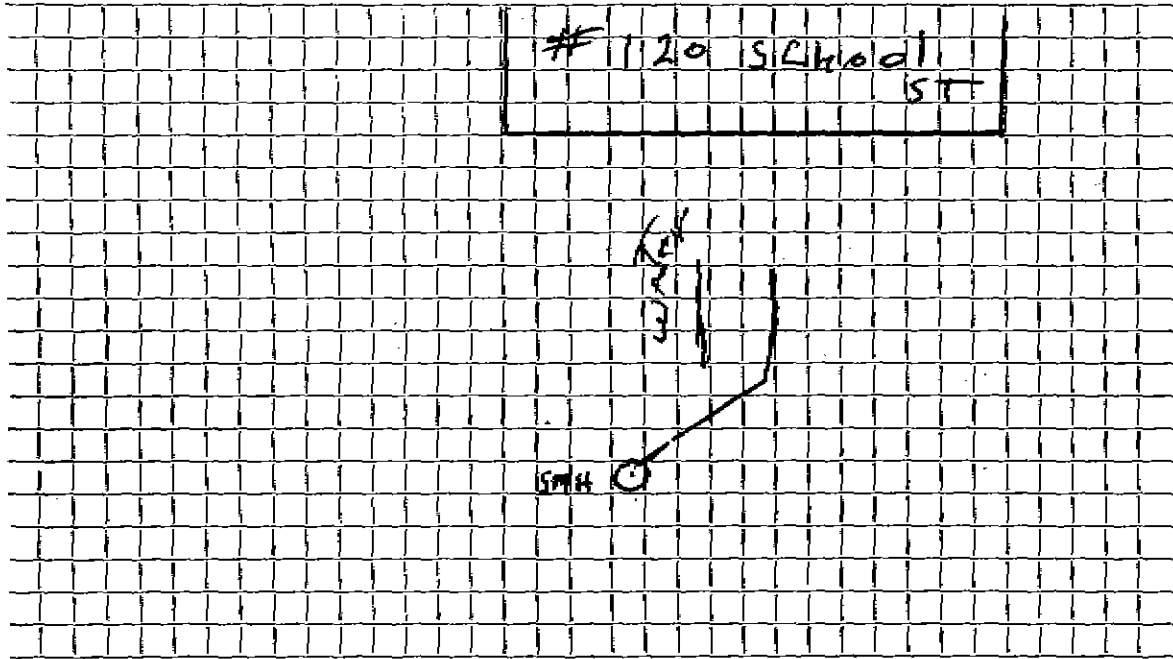

Connection made in Street.

Work completed Sewer 15'

Remarks: Service goes INTO Manhole below water service at Property line