




DATE \_\_\_\_\_

TOWN OF LEXINGTON — BOARD OF PUBLIC WORKS

SEWER DIVISION

Sketch of Service Here

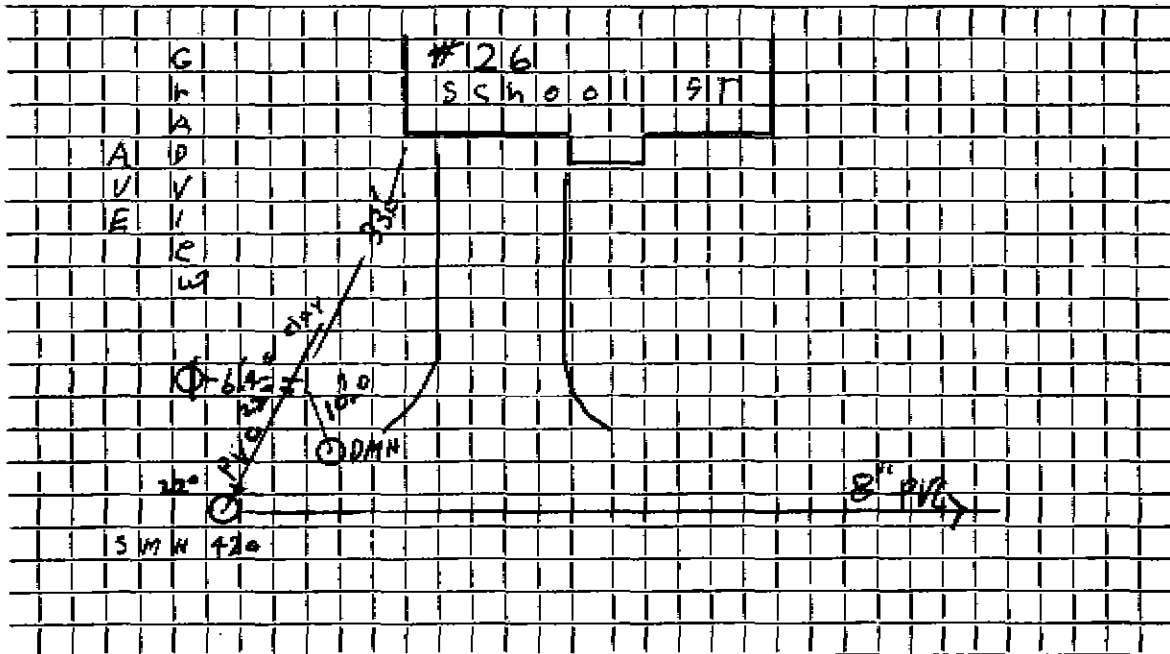

Connection made in \_\_\_\_\_ Street. Work completed 8/21/08 Andrea SSI

Remarks: Sewer service below - Water, Drains