


DATE _____

TOWN OF LEXINGTON — BOARD OF PUBLIC WORKS

SEWER DIVISION

Sketch of Service Here

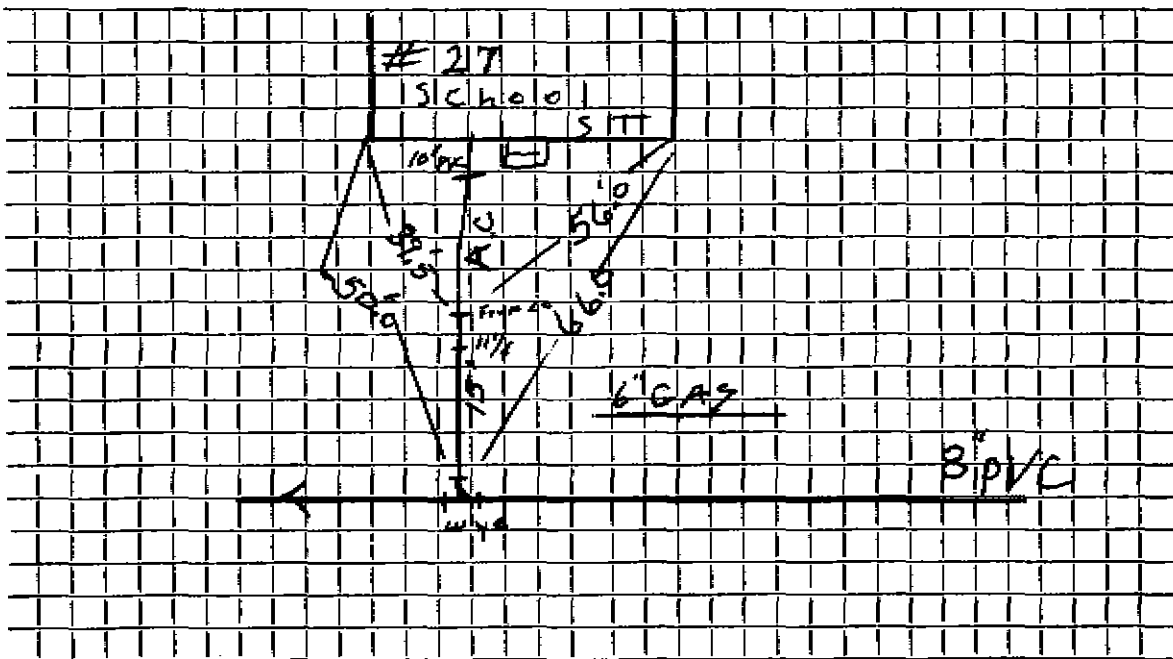

Connection made in Street.

Work completed 8/20/08 Andreassi

Remarks: 2-11' 1/4 bends