


DATE _____

TOWN OF LEXINGTON — BOARD OF PUBLIC WORKS
SEWER DIVISION

Sketch of Service Here

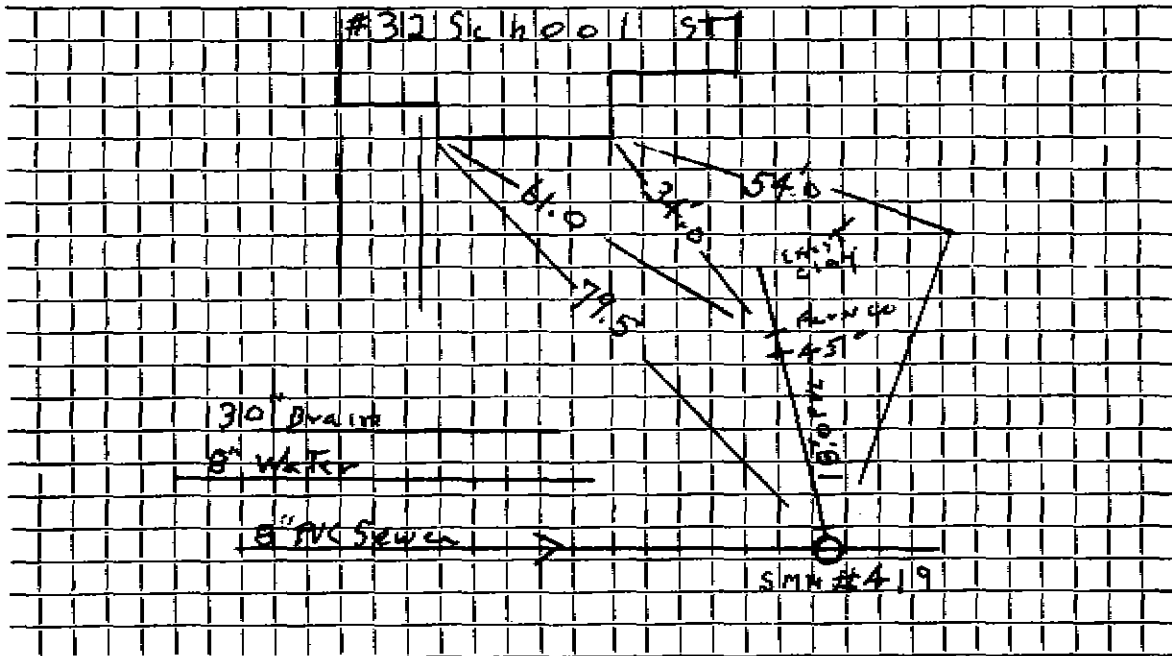

Connection made in School St. into M.H. Street. Work completed 8/20/08 Andreassi

Remarks: Sewer Service set Above Drain and Water Main