




DATE \_\_\_\_\_

**TOWN OF LEXINGTON — BOARD OF PUBLIC WORKS**  
**SEWER DIVISION**

Sketch of Service Here

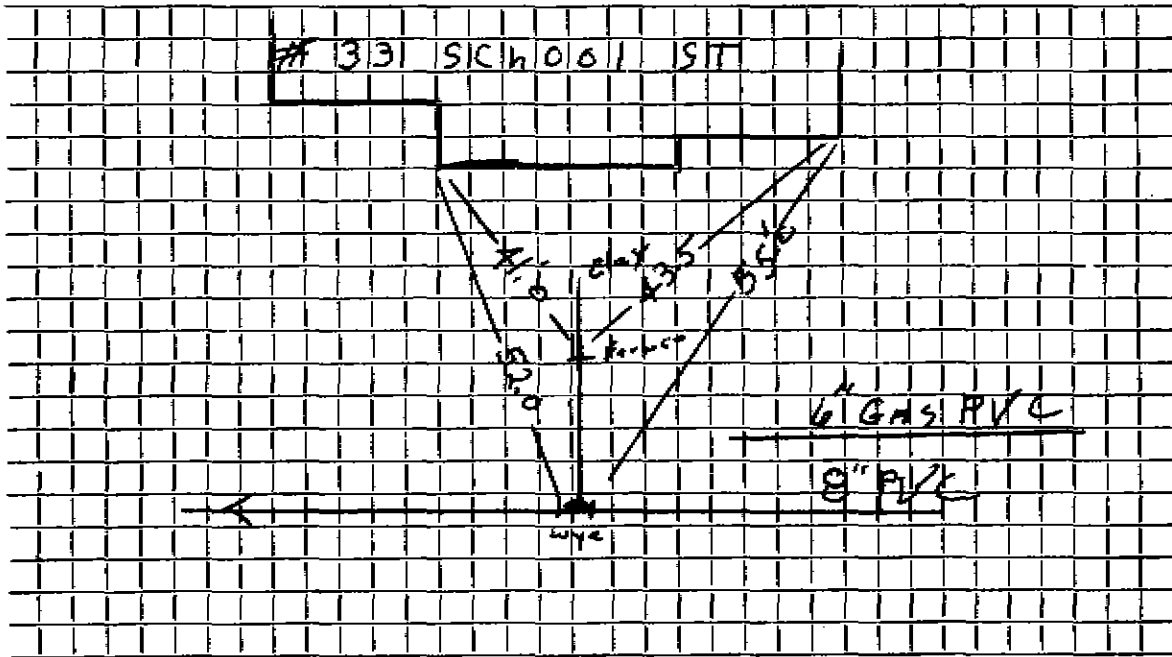

Connection made in School St Street. Work completed 8/20/08 Andreassi

Remarks: .....

.....

.....