


DATE _____

TOWN OF LEXINGTON — BOARD OF PUBLIC WORKS
SEWER DIVISION

Sketch of Service Here

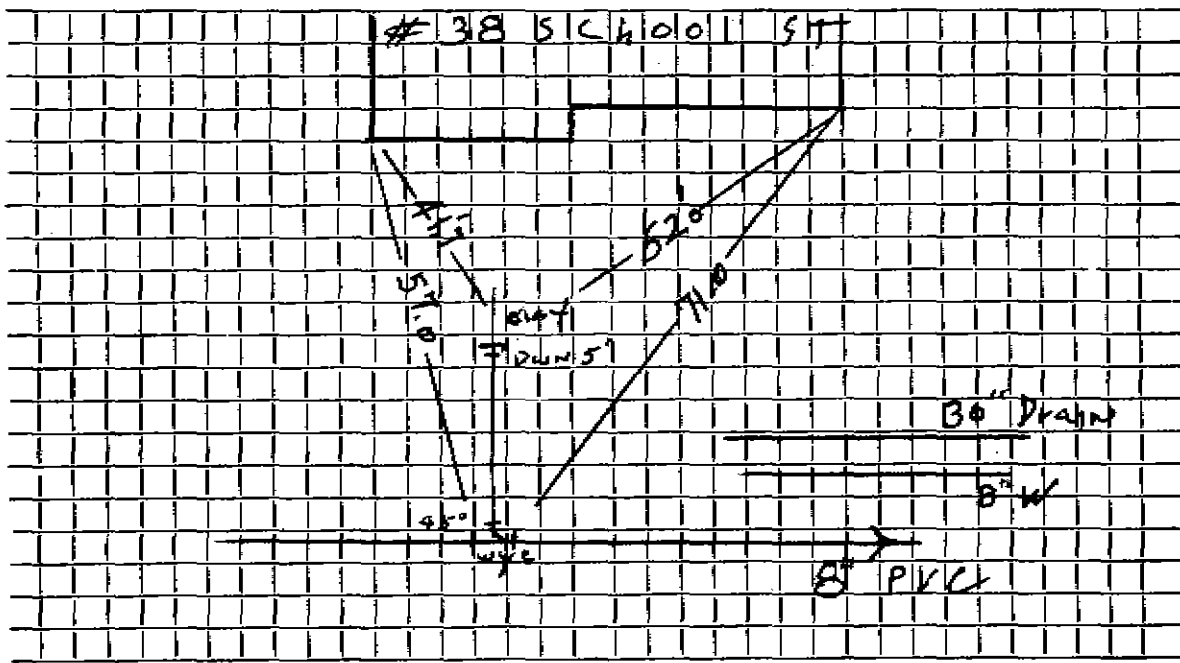

Connection made in School St Street. Work completed 8/20/08 Address

Remarks: Sewer Service goes Under Water & Drain Pipe

.....

.....