




DATE \_\_\_\_\_

TOWN OF LEXINGTON — BOARD OF PUBLIC WORKS  
SEWER DIVISION

Sketch of Service Here

41

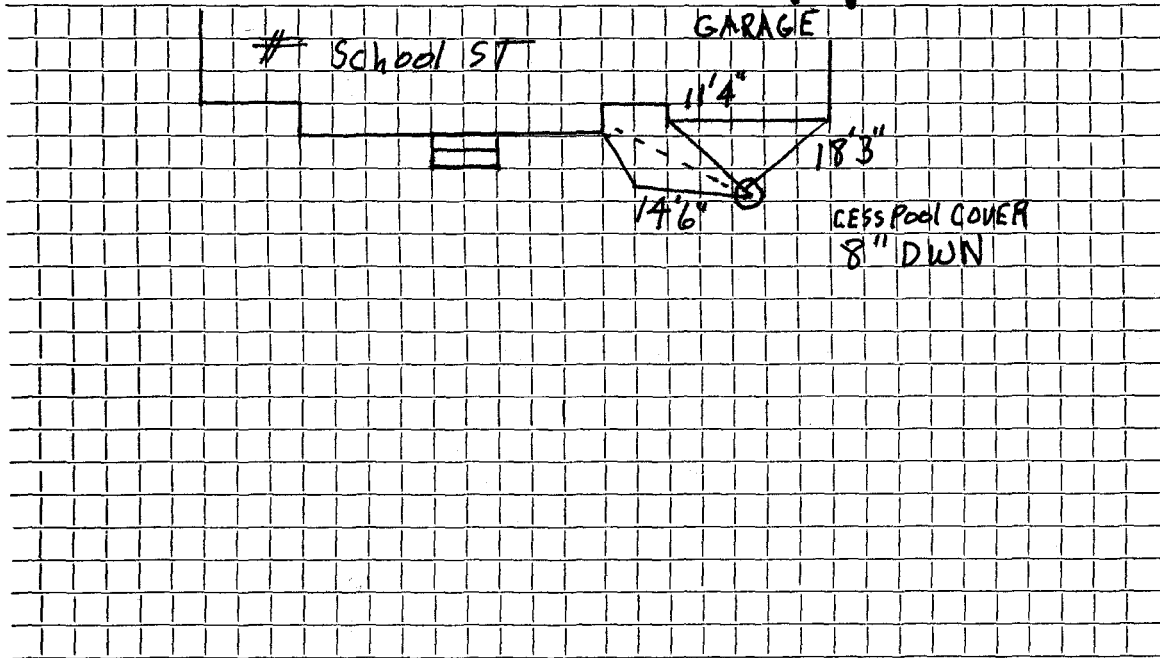

Connection made in ..... Street. Work completed .....

Remarks: Original Service 6-28-60 (75'-6" Transite) .....