

Name Anna Von ~~Bur~~

Service No. 47

Address 141 School Street

44 School Street

Location

Kind of Pipe

Size 6"

Size of Main 8"

~~Repair~~ ~~Renewal~~ — New Service

COM. 5-3-54

Location

Date	Material	Amount	Total	Date	Amount
4/15/54	Labor	82 25		4-8-54	Deposited 175 00
	10% overhead	8 23	90 48	5-4-54	Refunded (47 77)
	38'-6" Sewer pipe @.3087		11 73		127 23
	1-6"-1/8 Bend		1 24		
	Joint compound		2 28		
	4 hr Town shovel @ 5.00		20 00		
	2 hr trucking		1 50		
			127 23		
	Labor				

**TOWN OF LEXINGTON—DEPT. OF PUBLIC WORKS**  
**SEWER DIVISION**

DATE.....

NO. ....

The undersigned applies for the construction of a particular sewer connecting No.....  
Street and hereby agrees to comply with the Rules and Regulations governing the construction and use of Particular  
Sewers, as now or at any future time established by the Board of Selectmen.


Am't of estimate \$.....

Am't Paid \$.....

..... Owner

---

**Sketch of Service Here**

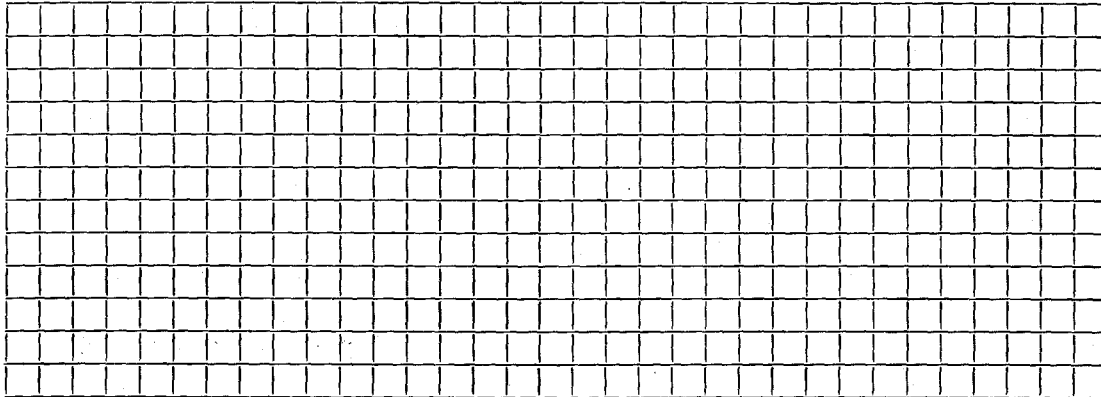

Connection made in..... Street.

Work completed.....19..

Remarks: