

Name John F. Foley

Service No. 26

Address 54 School Street

54 School Street

Location

L.T.126

Kind of Pipe

Size 6"

Size of Main 8"

~~REPAIR WORK~~ New Service

COM. 5-3-54

Location

Date	Material	Amount	Total	Date	Amount
4/8/54	Labor	68 00		5-26-54	Deposited 175 00
	10% overhead	6 80	74 80	5-4-54	Refunded 59 86
	46'-6" sewer pipe @.3087		14 20		115 14
	1-6" Elbow		1 88		
	Joint compound		2 76		
	4 hr town shovel @5.00		20 00		
	2 hr trucking		1 50		
			115 14		
2008	This Sec. of MAINT Service NOT Replaced was OK				
	Labor				

TOWN OF LEXINGTON—DEPT. OF PUBLIC WORKS
SEWER DIVISION

DATE.....

NO.


The undersigned applies for the construction of a particular sewer connecting No.....
Street and hereby agrees to comply with the Rules and Regulations governing the construction and use of Particular
Sewers, as now or at any future time established by the Board of Selectmen.

Am't of estimate \$.....

Am't Paid \$.....

..... Owner

Sketch of Service Here

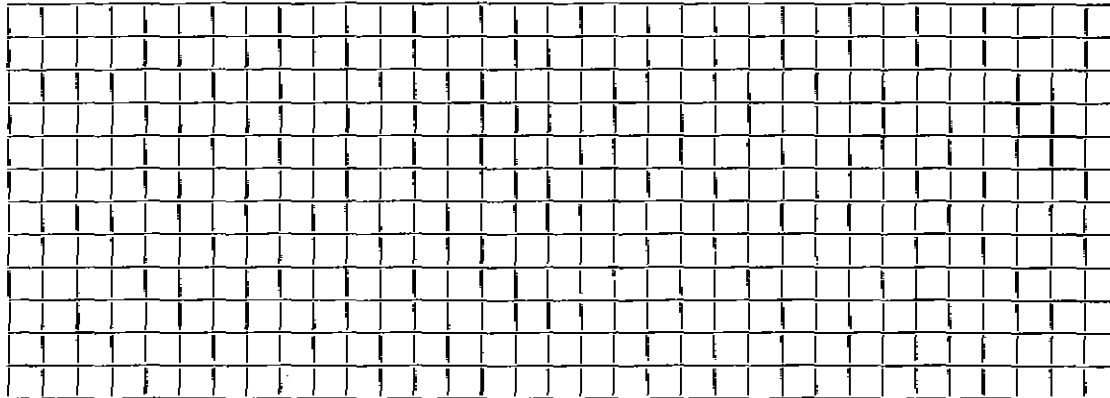

Connection made in..... Street.

Work completed.....19..

Remarks: This Sec. Sewer main NOT Replaced was OK - Service NOT Replaced.