


DATE _____

TOWN OF LEXINGTON — BOARD OF PUBLIC WORKS
SEWER DIVISION

Sketch of Service Here

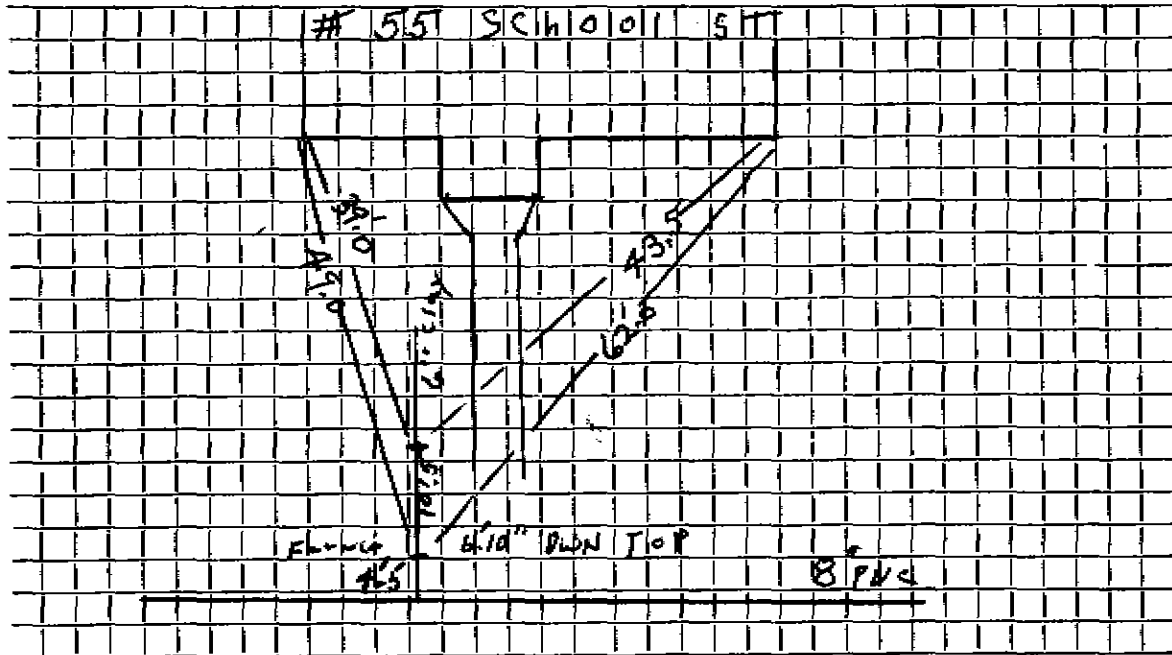

Connection made in School St Street. Work completed 8/28/08

Remarks: Furnace to be replaced with Curliug + short piece of PVC to new main 8" PVC