

Name

Service No.

Address

58 School ST

Location

1

Kind of Pipe

PVC + Clay

Size

6"

Size of Main

8" PVC

Repair—Renewal—New Service

Address

Location

LOT 127

Date

Material

Amount

Total

Date

Amount

8/27/08

19' 6" PVC

1 6" Fernco PVC-clay

4.5 6" PVC + Coupling

To house

4/26/54


Existing

6" Clay Pipe

DATE \_\_\_\_\_

TOWN OF LEXINGTON — BOARD OF PUBLIC WORKS  
SEWER DIVISION

Sketch of Service Here

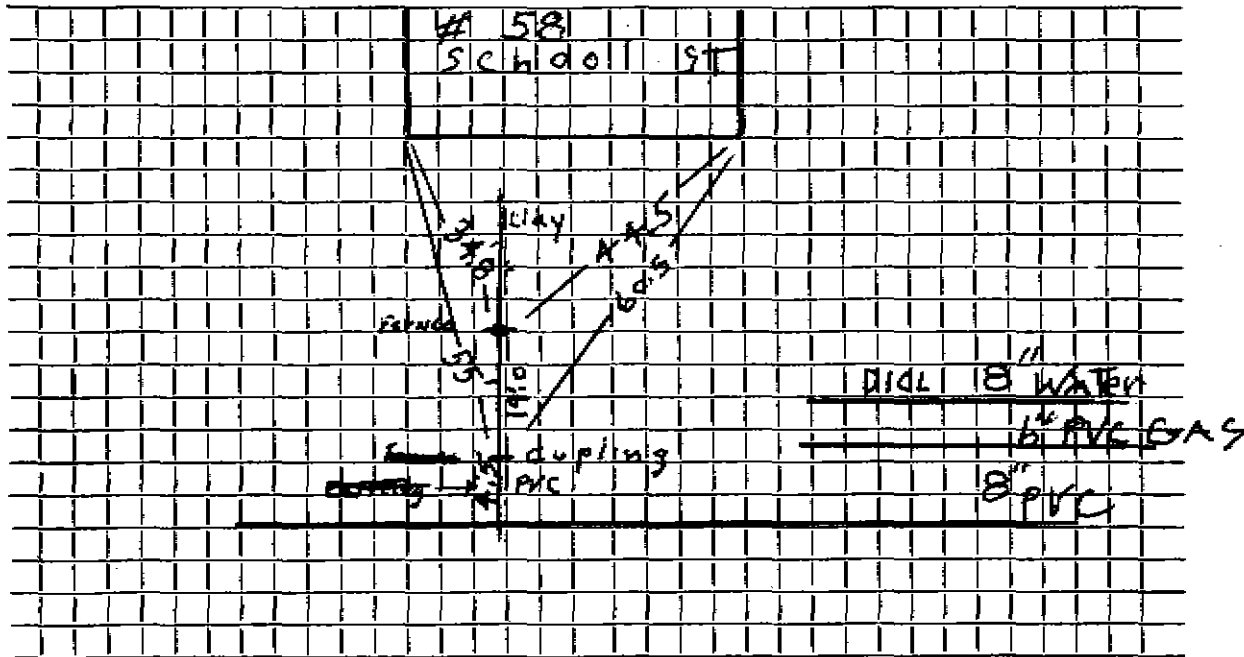

Connection made in School St Street. Work completed 8/27/08 Androssi.

Remarks: 6\" PVC Sewer goes over Water main, Under Gas main  
Temp. Farmco removed coupling + pieces pipe INST To new main