


DATE _____

TOWN OF LEXINGTON — BOARD OF PUBLIC WORKS
SEWER DIVISION

Sketch of Service Here

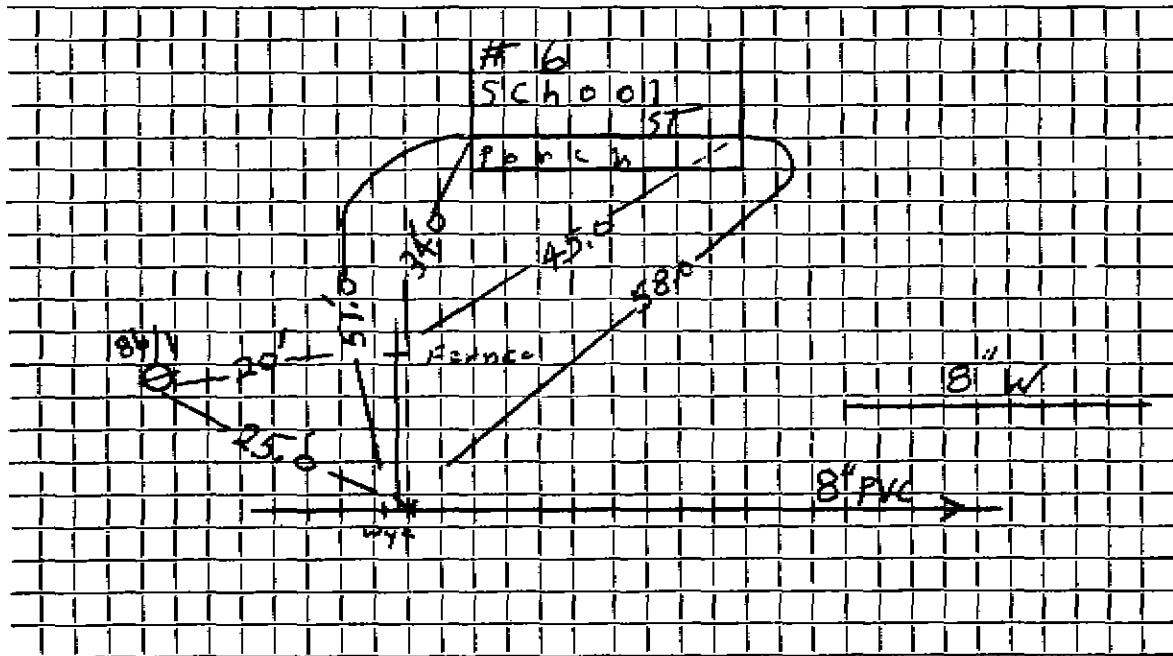

Connection made in School ST Street. Work completed 8/21/08 Andreassi

Remarks: Service Sewer under Water Main