




DATE \_\_\_\_\_

TOWN OF LEXINGTON — BOARD OF PUBLIC WORKS

SEWER DIVISION

Sketch of Service Here

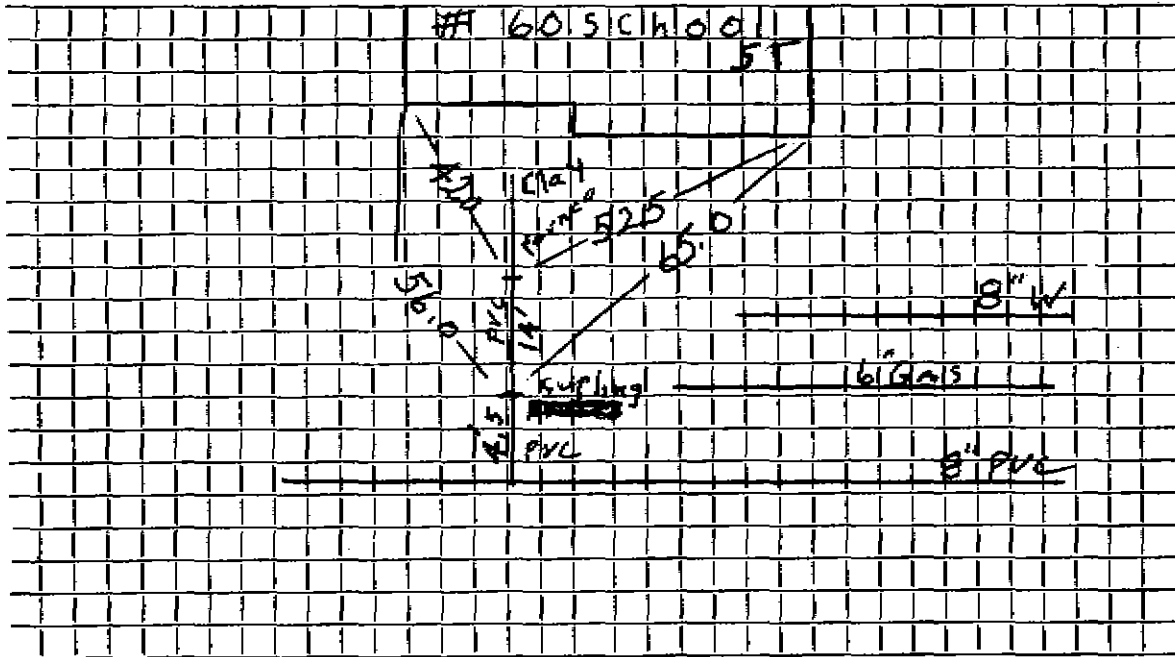

Connection made in School ST Street. Work completed 8/27/08 Andreassi

Remarks: ferroc removed coupling + pieces of pvc to main 4.5