

Name

Service No.

Address

66 School ST

Location

LOT 129

Kind of Pipe

PVC

Size

6"

Size of Main

8" PVC

Repair—Renewal—New Service

Andreassi

Location

Date

Material

Amount

Total

Date

Amount

8/28/08

19'

6" PVC

1

Clay & PVC Fitted

1

Coupling TOMAING

4.5

6" PVC

Existing to house


10/22/54

6" Clay Pipe

DATE \_\_\_\_\_

TOWN OF LEXINGTON — BOARD OF PUBLIC WORKS  
SEWER DIVISION

Sketch of Service Here

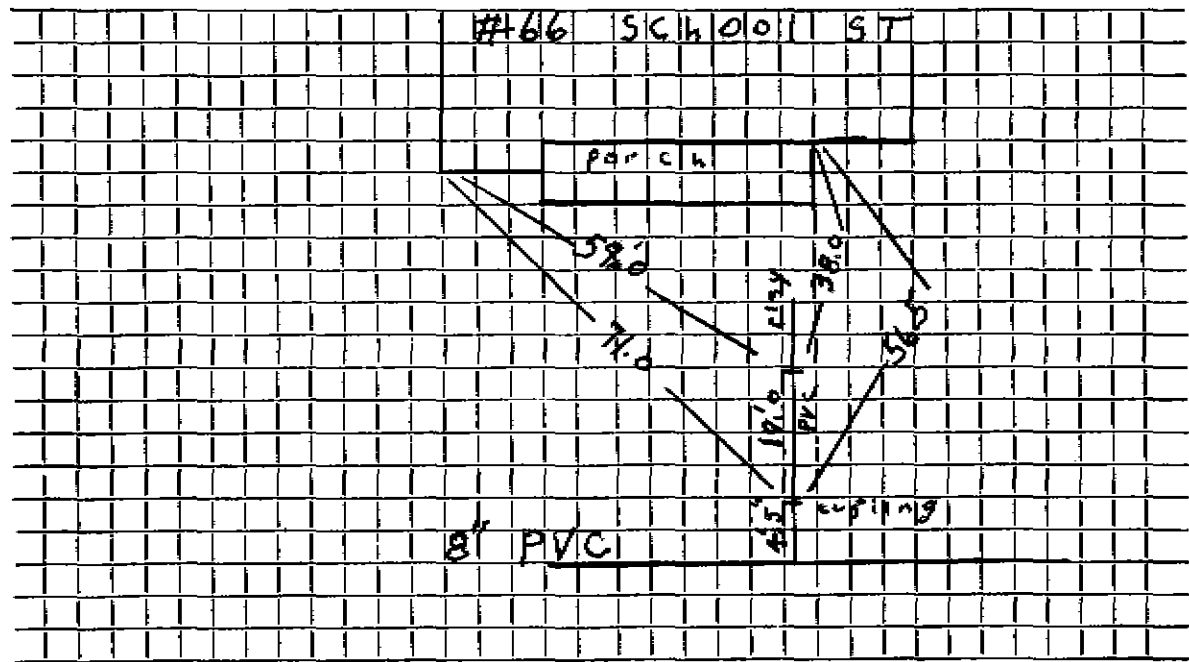

Connection made in \_\_\_\_\_ Street. Work completed 8/28/08 Andreassi

Remarks: Remove <sup>inst</sup> coupling + PVC 105' To New Sewer Main

Sewer Goes Under both Water Mains + Gas Main