




DATE \_\_\_\_\_

# TOWN OF LEXINGTON — BOARD OF PUBLIC WORKS

## SEWER DIVISION

Sketch of Service Here

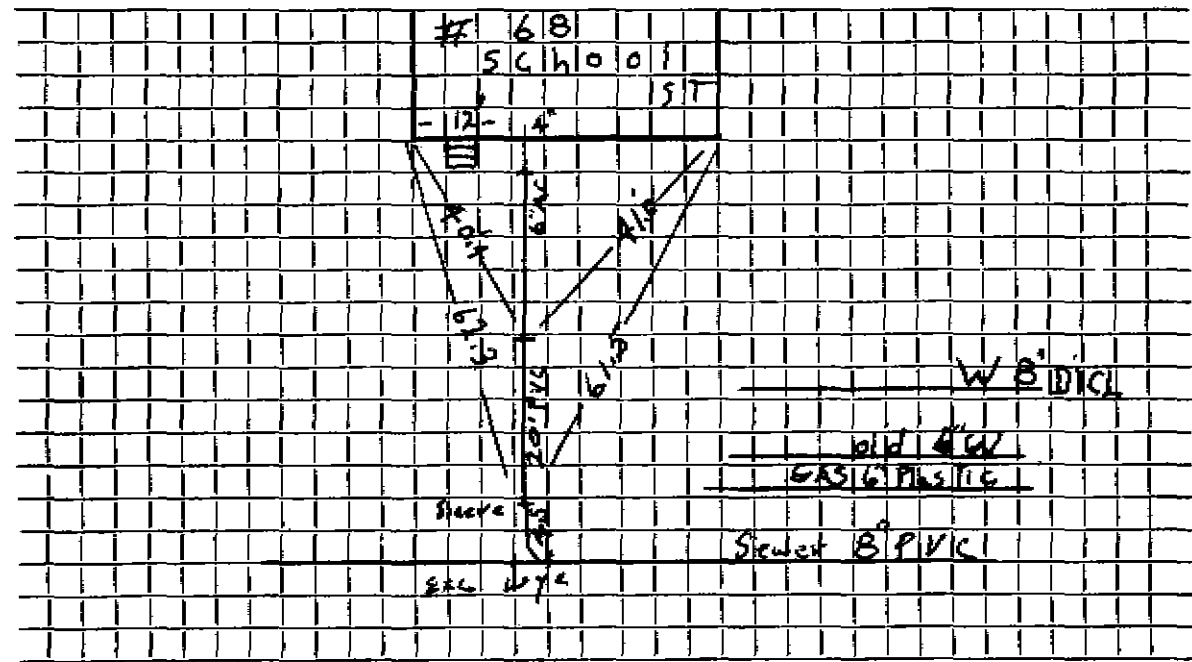

Connection made in School St..... Street. Work completed 9/2/08 Addresses.....

Remarks: Sewer service below old water and 6" Gas / over New 8" water.....