

Name Hugh Thompson

Service No. 70

Address 7 School St.

Location

Kind of Pipe

Russell Sibley #A305 Size 6"

Size of Main 8"

~~Capacity~~ New Service W.O. #2428

Location SEP 19 1966

Date	Material	Amount	Total	Date	Amount
6-8-66	Labor 98.10			5-25-66	150 00
7-8-66	Patching 19.18	117 28		9-27-66	49 85
	10% O.H.	11 73	129 01	6-8-66	199 85
	30' 6" Transite pipe @ .88		26 40	30' 6" Transite	
	1 1 1/4" Elbow		2 35	1 6"-1 1/4" Elbow	
	1 1 1/4" Bend		4 09	1 6"-1 1/4" Bend	
	1 1/2" Ton hot top @ 5.50		2 75	1 6"X8" Wye	
	1 Yd. Loam		3 00		
	7 1/2 Hrs. Trucking @ 3.00		22 50		
	1 Hr. Loader		4 00		
	1/2 Tractor @ 6.50		3 25		
	1/2 Hr. Compressor @ 5.00		2 50	6/19/73	Roots
			199 85		
7/6/66	112' 6" Transite pipe				
					Bill sent 4985

DATE \_\_\_\_\_


TOWN OF LEXINGTON — BOARD OF PUBLIC WORKS

SEWER DIVISION

Now 7 School ST

Sketch of Service Here

2564

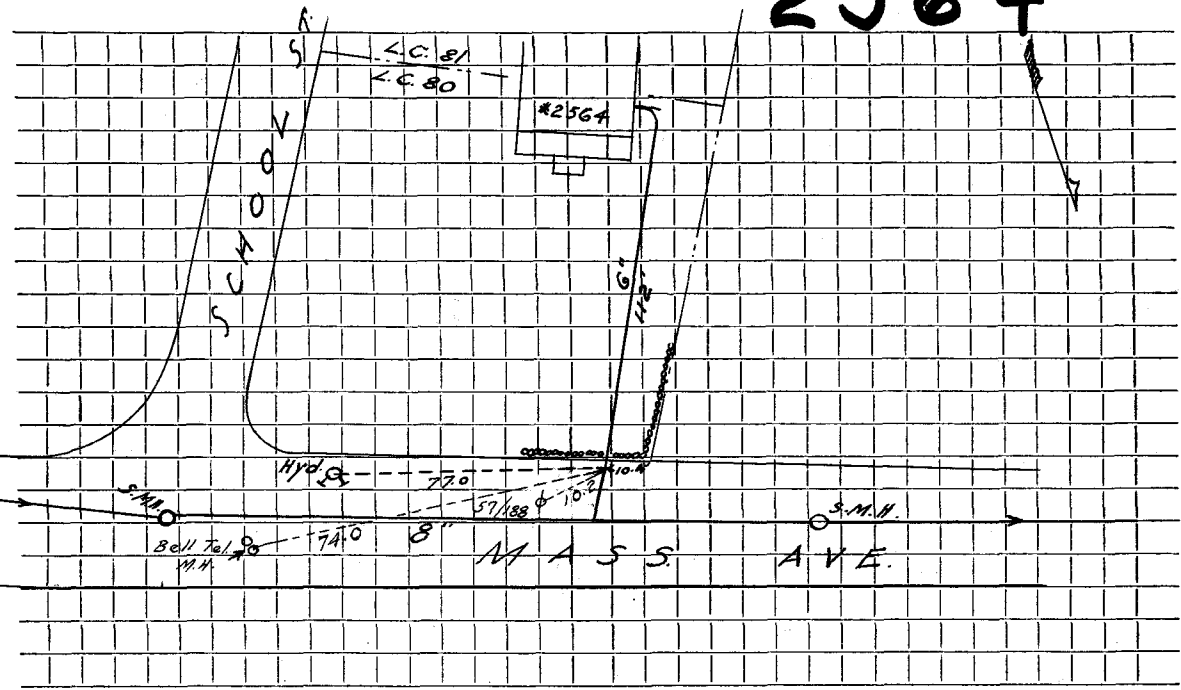

Connection made in ..... Street. Work completed .....

Remarks: .....  
.....  
.....