

Name

Service No.

Address

70 School ST

Location

Lot 130A

Kind of Pipe

Size

Size of Main

Repair—Renewal—New Service

Location

Date

Material

Amount

Total

Date

Amount

9/2/08

20' 6" PVC

1

PVC clay Ferruco

1

6" Sleeve

4.5

6" PVC

1

8" wye

6/54

8" 1/2" clay pipe

12/60


20' 4" clay pipe?

DATE _____

TOWN OF LEXINGTON — BOARD OF PUBLIC WORKS

SEWER DIVISION

Sketch of Service Here

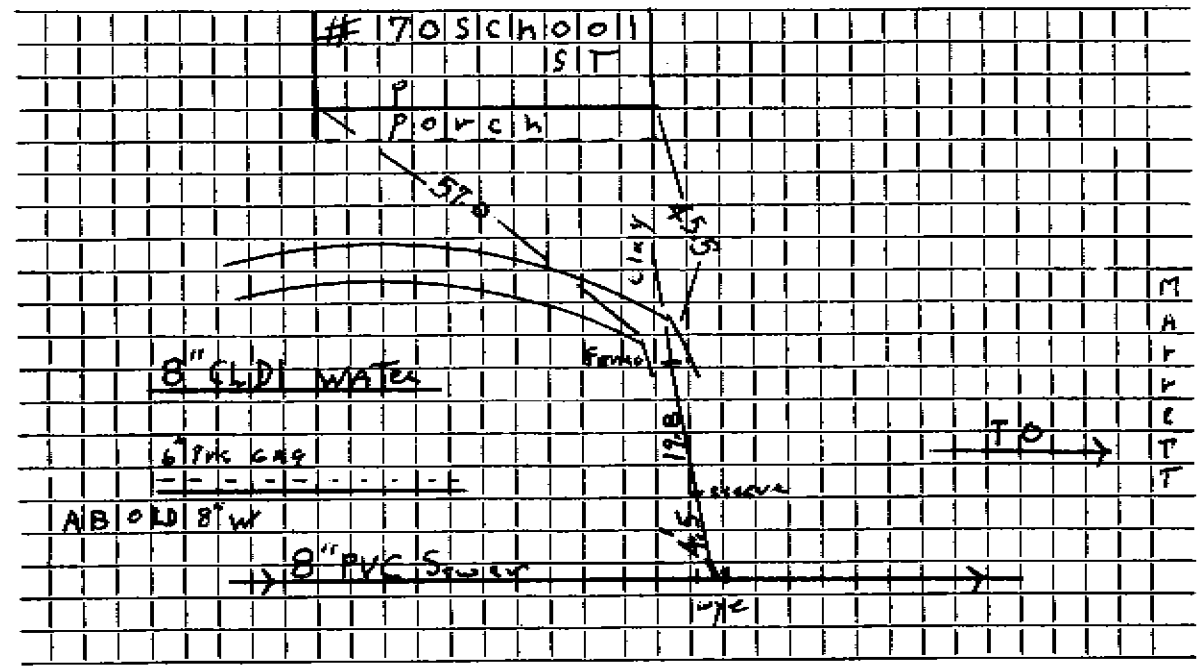

Connection made in _____ Street. Work completed 9/08 Andreasen

Remarks: 6" Gas PVC Directly Above old 8" WATER AB.