

Name

Service No.

Address

74 School ST

Location

LOT 131

Kind of Pipe PVC

Size 6"

Size of Main 8" PVC

Repair—Renewal—New Service

Location

Date

Material

Amount

Total

Date

Amount

9/2/68 25' 6" PVC

1 6" Fernco PVC x clay

1 6" sleeve

4.5 6" PVC

1 8" wye

Existing


11/18/54

6" Clay Pipe

DATE _____

TOWN OF LEXINGTON — BOARD OF PUBLIC WORKS
SEWER DIVISION

Sketch of Service Here

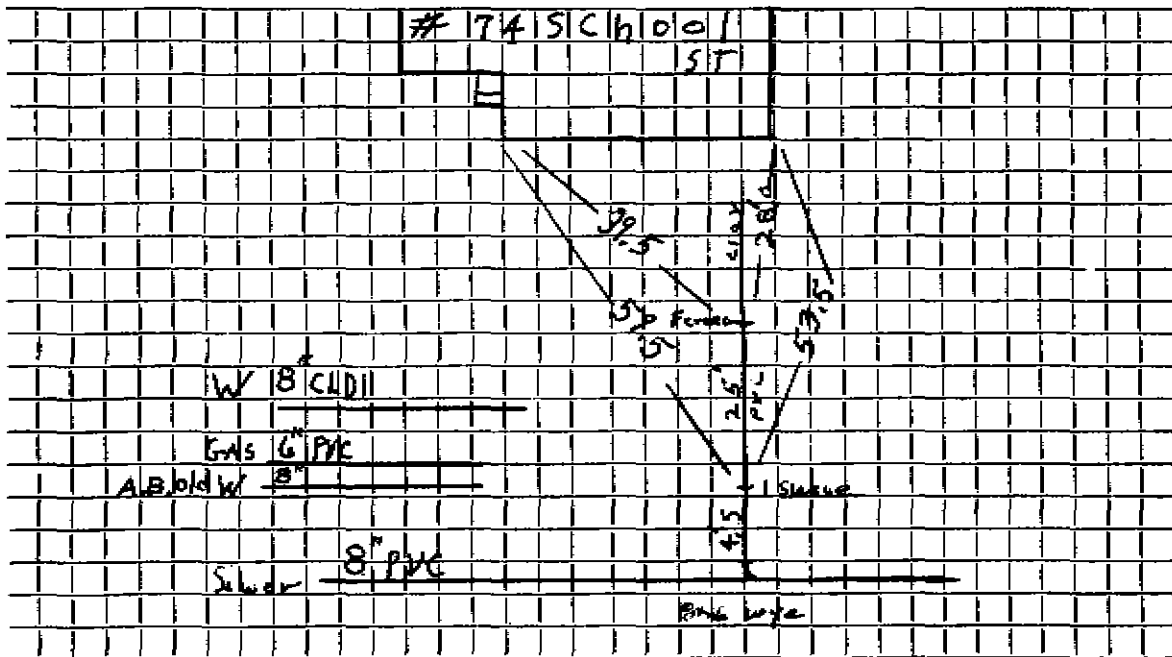

Connection made in Street. Work completed 9/2/08 Andressi

Remarks:
.....
.....