

Name

Service No.

Address 75 School ST

Location

LOT 120

Kind of Pipe PVC

Size 6"

Size of Main 8" PVC

Repair—Renewal—New Service An ~~Address~~

Location

Date	Material	Amount	Total	Date	Amount
------	----------	--------	-------	------	--------

9/4/08	9' 0" 6" PVC				
--------	--------------	--	--	--	--

	1-6" PVC Founco To AC				
--	-----------------------	--	--	--	--

	1 8X6 Tee wye				
--	---------------	--	--	--	--

	EXIST				
--	-------	--	--	--	--


	6" A.C.				
--	---------	--	--	--	--

7/17/62	? MAY be PVC				
---------	--------------	--	--	--	--

DATE _____

TOWN OF LEXINGTON — BOARD OF PUBLIC WORKS
SEWER DIVISION

Sketch of Service Here

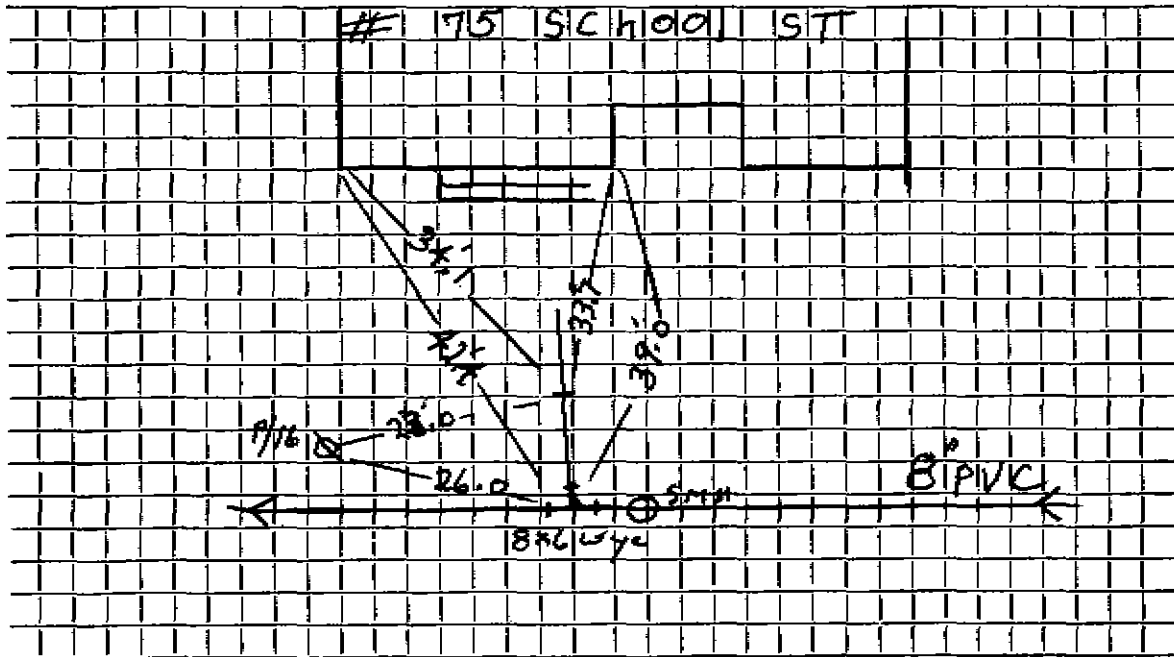

Connection made in Street. Work completed 10/21/08 Anderson

Remarks: Maybe P.V.C. To house