




DATE \_\_\_\_\_

TOWN OF LEXINGTON — BOARD OF PUBLIC WORKS  
SEWER DIVISION

Sketch of Service Here

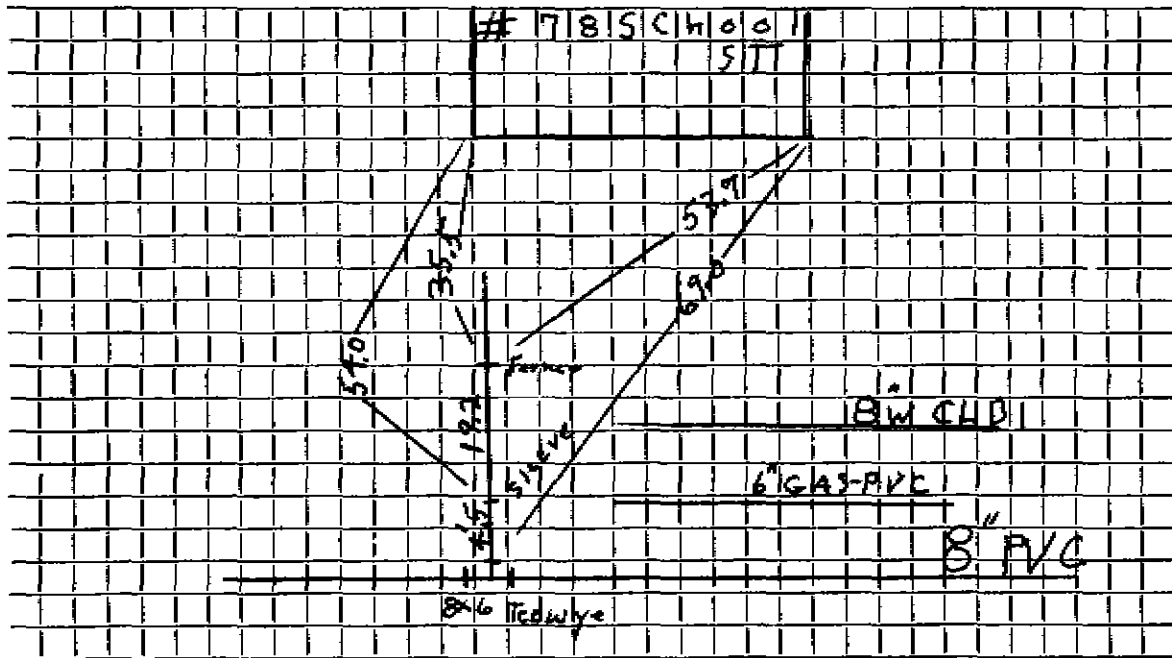

Connection made in ..... Street. Work completed ..... OB Andrews

Remarks: 5.6" PVC Service goes Under gas/over 8" WATER