




DATE \_\_\_\_\_

**TOWN OF LEXINGTON — BOARD OF PUBLIC WORKS**  
**SEWER DIVISION**

Sketch of Service Here

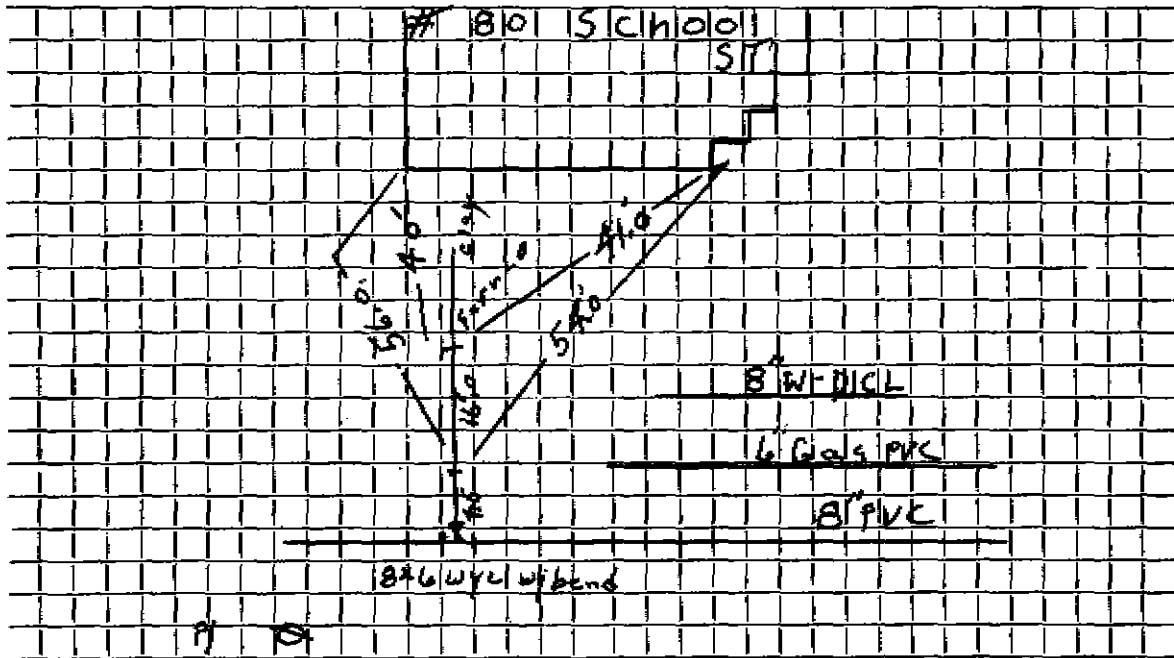

Connection made in \_\_\_\_\_ Street.

Work completed 9/4/08 Address \_\_\_\_\_

Remarks: sewer service from MAIN TO GAS + or -  
.....  
.....