

Name

Service No.

Address 83 School ST

Location

LOT 118

Kind of Pipe PVC

Size 6"

Size of Main 8" PVC

Repair—Renewal—New Service

Advanced


Location

Date	Material	Amount	Total	Date	Amount
11/19/07	10' 4" PVC				
	32' 6" PVC				
10/16/08	14.5' 6" PVC				
	1' 6" PVC solid sleeve				
	1' 22° + 45° @ Tie in. Swevel Joints				
	1' 8x6 PVC. Wye				
	(Manny - W+S - Eng This service needs Backflow Preventor Pipe flat				

DATE _____

TOWN OF LEXINGTON — BOARD OF PUBLIC WORKS
SEWER DIVISION

Sketch of Service Here

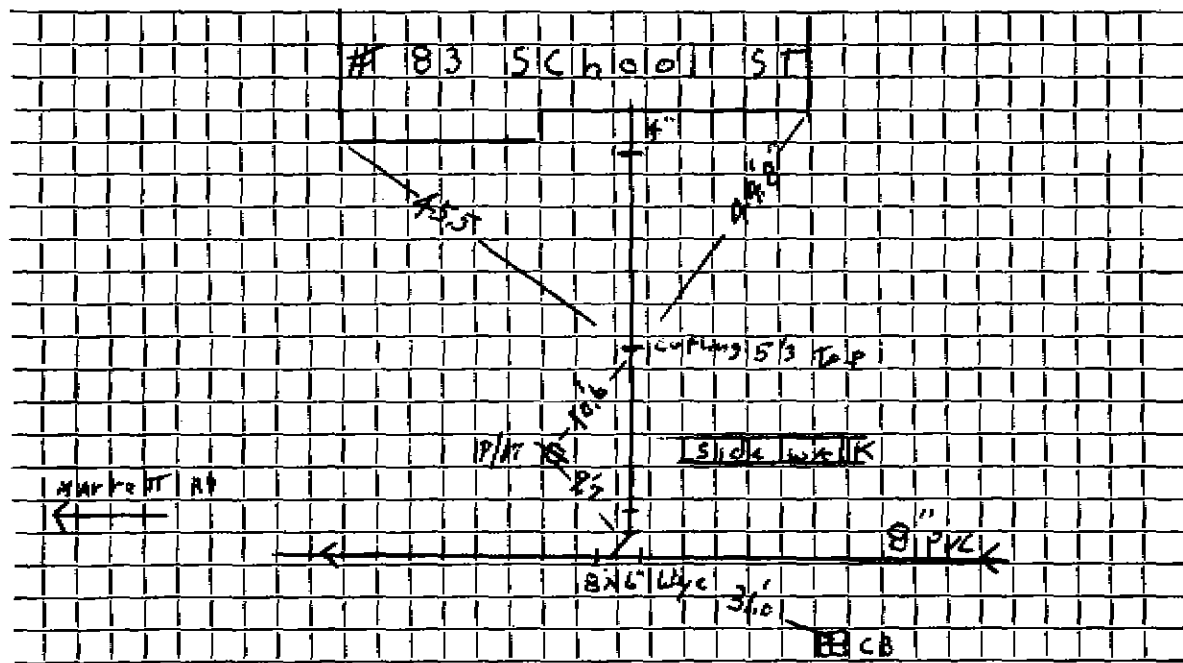

Connection made in School St Street. Work completed 10/16/08 Address

Remarks: P.P.P. Very little P.I.T.A.