


DATE _____

TOWN OF LEXINGTON — BOARD OF PUBLIC WORKS

SEWER DIVISION

Sketch of Service Here

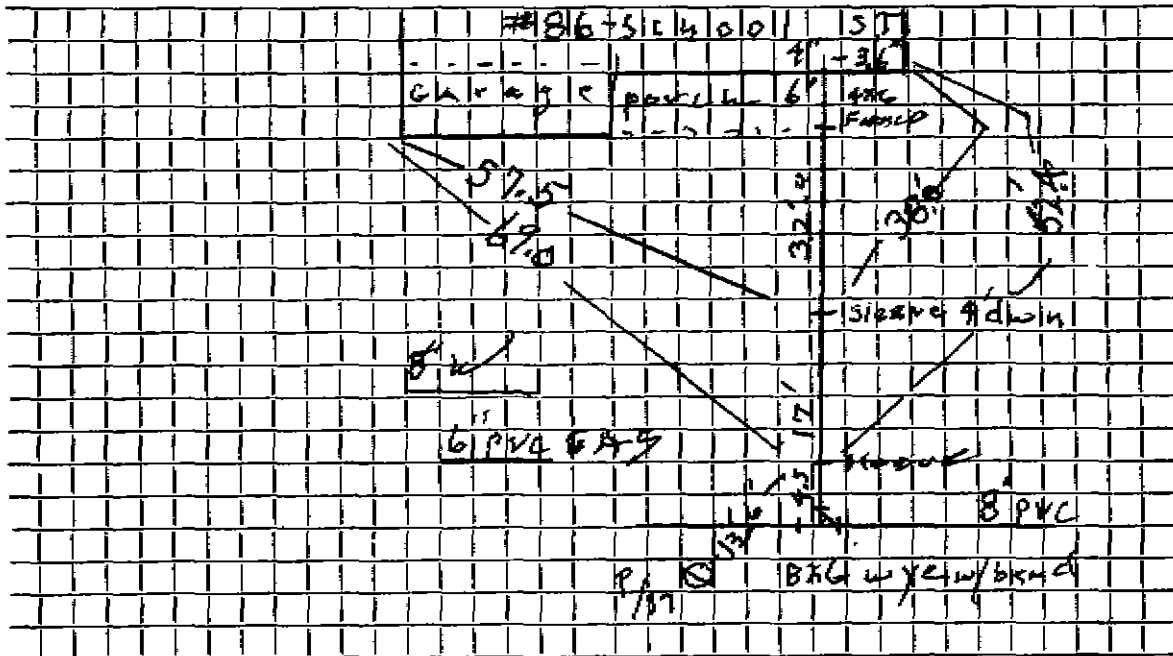

Connection made in Street.

Work completed 5/22/08 J. McI-

Remarks: outside - 9/4/08 Andrew S.S.J.