




DATE \_\_\_\_\_

TOWN OF LEXINGTON — BOARD OF PUBLIC WORKS

SEWER DIVISION

Sketch of Service Here

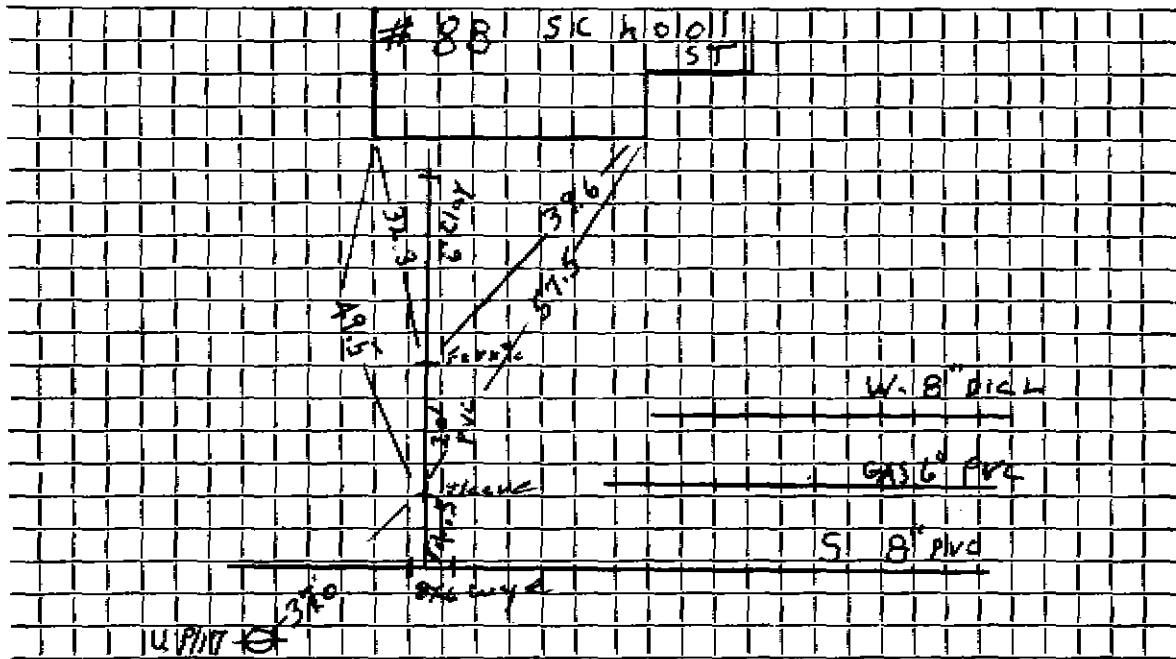

Connection made in ..... Street. Work completed 9/8/08 Address: .....

Remarks: Sewer Service PVC Under Gas, Over Water .....

.....

.....