

Name

Service No.

Address

92 School ST

Location

LOT 136

Kind of Pipe

Size

Size of Main

8" PVC

Repair—Renewal—New Service

ANDREASSI

Location

Date

Material

Amount

Total

Date

Amount

10/8/08

1

8x6 PVC Wye

8'

6" PVC

1

6" PVC coupling

7/30/08

17

6" PVC -- from exist pipe

prop. line
pipe to gas
main

1

6" clay x PVC Fanno

EXISTING


Clay Pipe

1955

DATE _____

TOWN OF LEXINGTON — BOARD OF PUBLIC WORKS
SEWER DIVISION

Sketch of Service Here

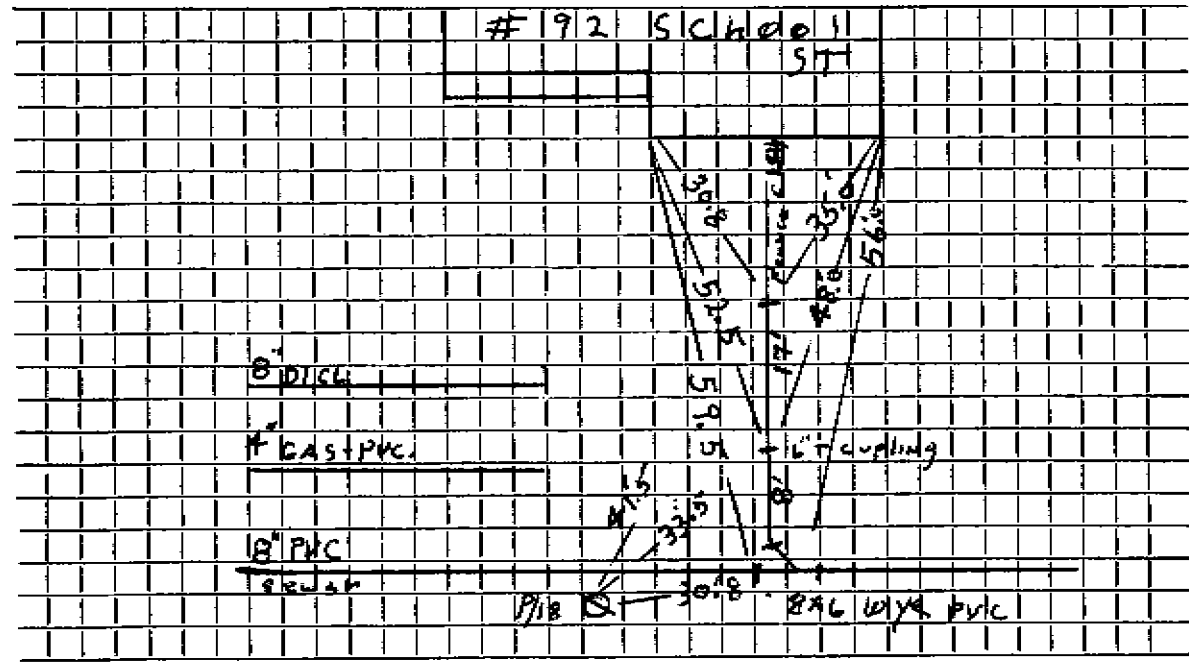

Connection made in Street. Work completed 10/8/08 Andrews

Remarks: Service Gas under Water Main and under 36" Drain