


DATE _____

TOWN OF LEXINGTON — BOARD OF PUBLIC WORKS

SEWER DIVISION

Sketch of Service Here

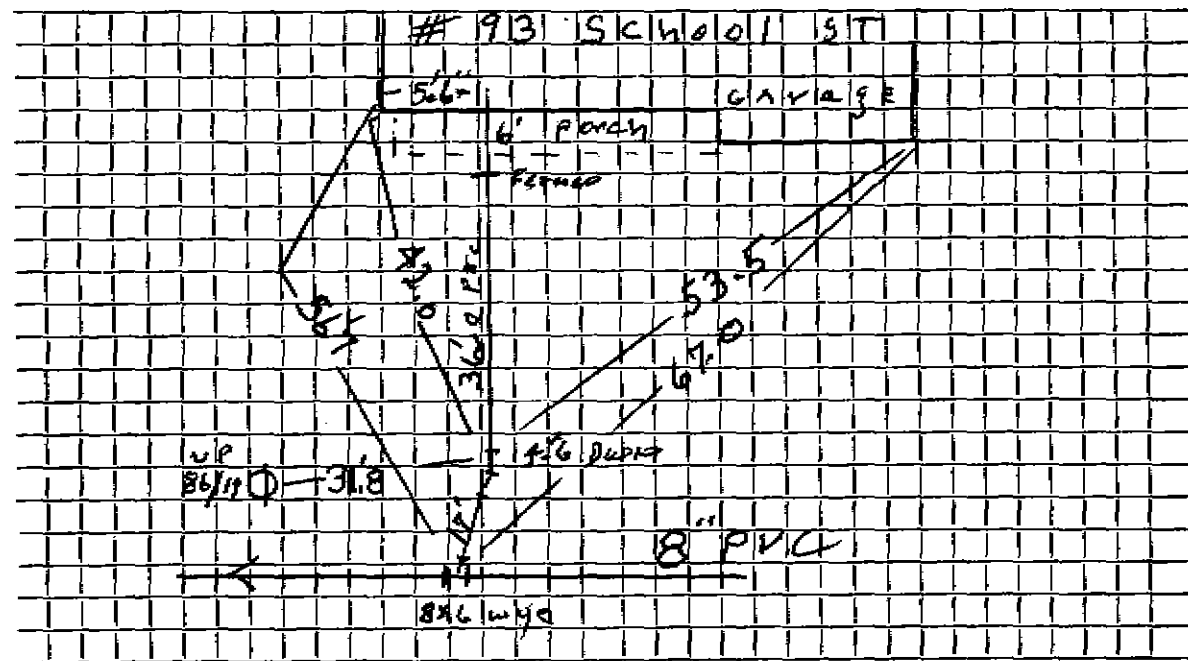

Connection made in _____ Street. Work completed 5/20/08 J. McC - IN

Remarks: 2-11 1/4" bends @ Tie IN. 10/9/08 Anderson - out