

Name

Service No.

Address 96 School ST

Location

LOT 137

Kind of Pipe PVC + clay

Size 6"

Size of Main 8" PVC

Repair—Renewal—New Service

Andreas

Location

Date

Material

Amount

Total

Date

Amount

9/8/08 24' 6" PVC

4.5' PVC

1 6" sleeve

2-6" 22° bends

1 8x6 wye w/bend

1-6" PVC X clay fence


4/12/54 Existing

To house 6" Clay Pipe

DATE _____

TOWN OF LEXINGTON — BOARD OF PUBLIC WORKS
SEWER DIVISION

Sketch of Service Here

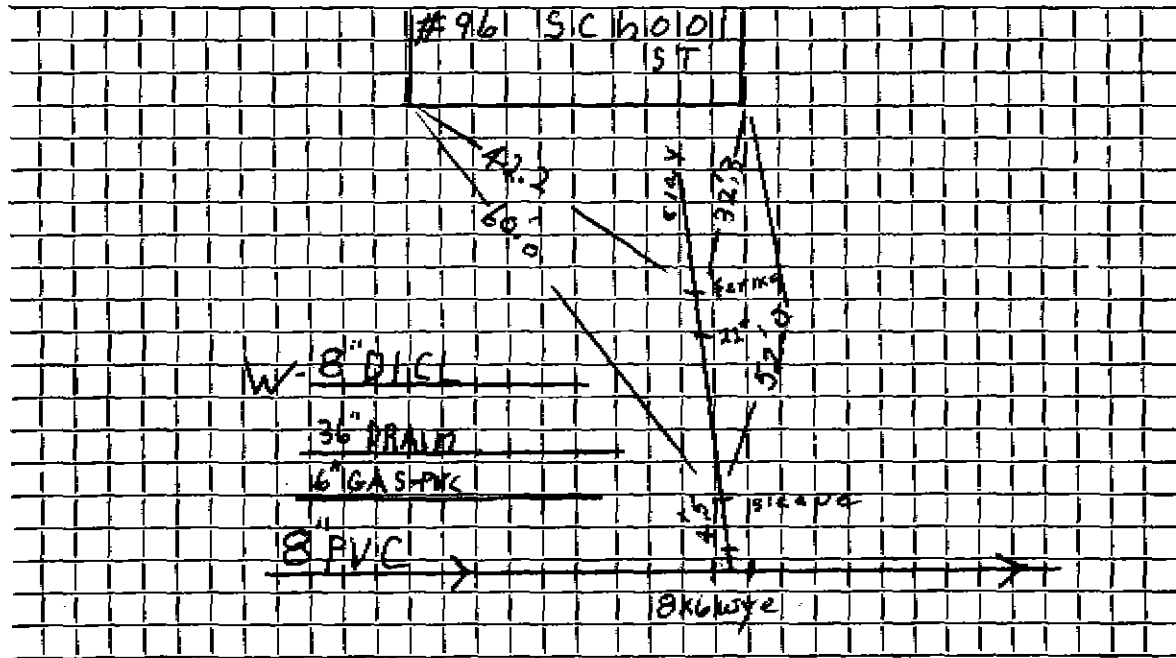

Connection made in Street. Work completed 9/8/08

Remarks: 6" PVC Sewer Goes Under All Pipes

.....
.....