

Name Allan Schell

Service No. 34

Address 1 Scotland Road

1 Scotland Road

Location

Kind of Pipe AC

Size 6"

Size of Main 8"

~~Repair - Renewal~~ New Service McGee #4600


Location

Date	Material	Amount	Total	Date	Amount
7-1 75	31'-6" AC at	\$10.00 =	\$310.00	9-23-86	310.00
10/9/86	32' 6" PVC			Deposit	
	8' 4" PVC				
	1 6" Wye				
	1 6" Wye Cleanout				
	1 6" x 4" Reducer				
	1 6" 45° Bend				
	1 6" 22° Bend				
	1 4" x 6" Donut				
	1 6" Fernco				
	1 4" x 3" Fernco				
	1 4" 22°				

DATE _____

TOWN OF LEXINGTON — BOARD OF PUBLIC WORKS
SEWER DIVISION

Sketch of Service Here /

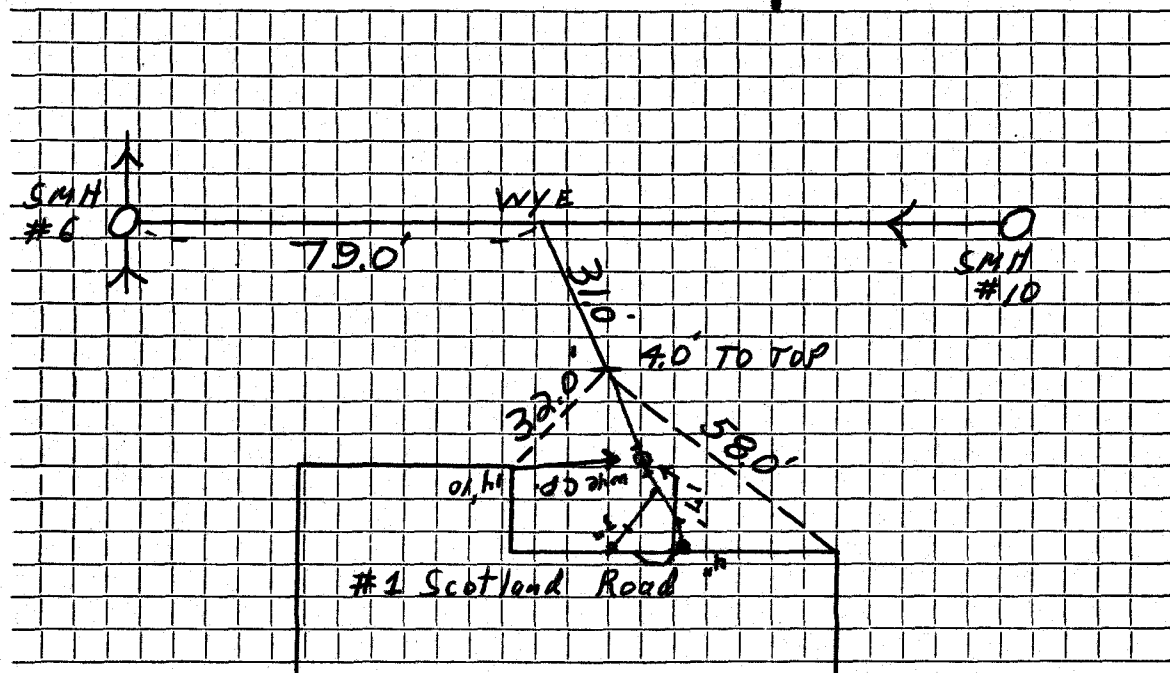

Connection made in Scotland Street. Work completed

Remarks: 2. Clean out by house. 3. Under sillcock, 4. To left of door,
..... New 6" C.O. See INSP. sheet for ties.