

Name Thomas L. Crowley

Service No. 3

Address 10 Scotland Road

10 SCOTLAND ROAD

Location

Kind of Pipe

Size 6"

Size of Main 8"

Repair or Renewal — New Service

WO# 8476

Location


Comm 5-18-64

Date	Material	Amount	Total	Date	Amount
01-/63	19.5' 6" A.C. installed by contractor @6.00 per foot	117 00		1-16-64 2-23-65	Deposit Paid 300 00 64 17 364 17
	BILL WHEN CONNECTED				
1-22-64	Labor 88.81				
4-17-64	" 25.04	113.85			
	10% O.H.	11.39	125.24		
	67' 6" Transite pipe @.82		54.94		
	1 6 x 6 Transite "Y"		4.09		
	2 11 ¹⁰ / ₄ Transite bends @4.09		8.18		
	1 11 ¹⁰ / ₄ Transite Elbow		2.35		
	7 3/4 ton 1 ¹ / ₂ " Stone @1.50		11.62		
	1 bag cement		1.55		
	5 yds. Loam @3.00		15.00		
	Fertilizer & Lime		1.20		
	2 hrs. Town Shovel @6.50		13.00		
	3 hrs. Trucking @3.00		9.00		
	1 hr. Pumping @1.00		1.00		
			364.17		

DATE _____

TOWN OF LEXINGTON — BOARD OF PUBLIC WORKS
SEWER DIVISION

Sketch of Service Here **10**

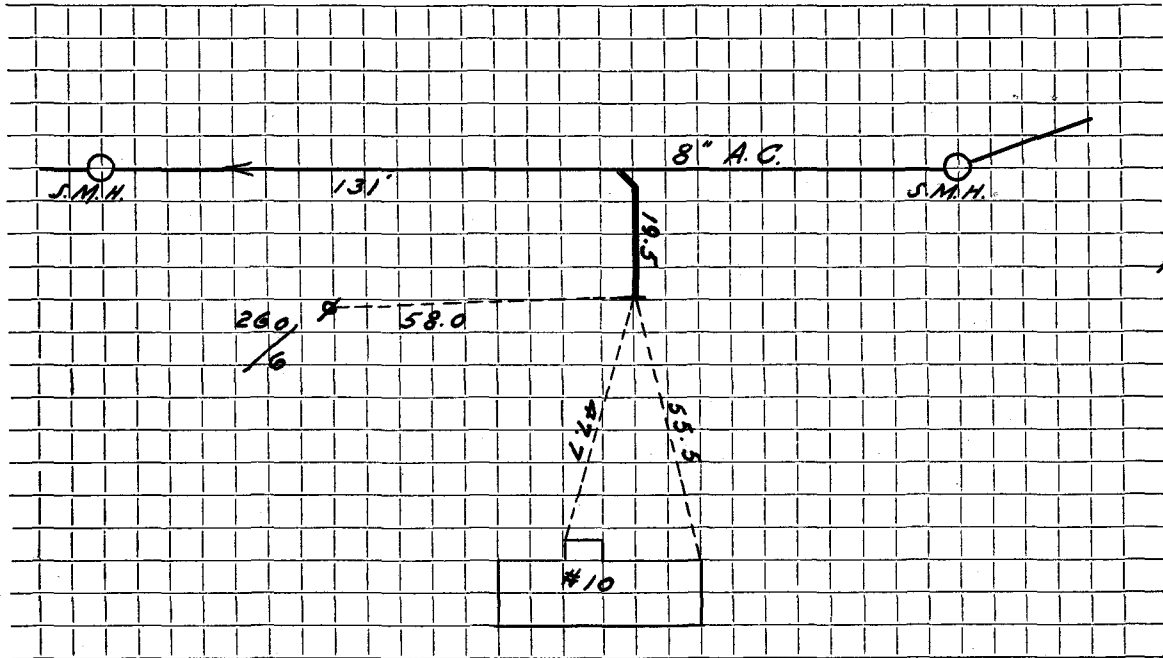

Connection made in Street. Work completed

Remarks:
.....
.....