

Name Irving Kessler

Service No. 215

Address 11 Scotland Road

11 Scotland Road

Location

Kind of Pipe

Size 6"

Size of Main 8"

~~Repair & Renewal~~ — New Service

WC # 8366

Location Comm 5-18-64


Date	Material	Amount	Total	Date	Amount
0/-/63	18.0' 6" A.C. installed by contractor @6.00 per foot	108 00		12-4-63 7-8-64	275 00 60 70 335 70
	BILL WHEN CONNECTED				
1-7-64	Labor 94.36				
4-13-64	" 11.81	106.17			
	10% O.H.	10.62	116.79		
66'	6" Transite pipe @ 82		54.12	7/55	13'-8" 6" PVC
1	6 x 6 Transite "Y"		4.09		
7	ton 1 1/2" Stone @1.50		10.50		
4	yds. Loam @3.00		12.00	1	6" w/2
	Lime & Turf builder		1.20	1	45° bend
3	hrs. Trucking @3.00		9.00	1	6" cap
2	hrs. Pumping @1.00		2.00	1	AC - PVC
1	hr. Loader @ 5.00		5.00		
2	hrs. Town Shovel @6.50		13.00		
			335.70		

DATE _____

TOWN OF LEXINGTON — BOARD OF PUBLIC WORKS

SEWER DIVISION

Sketch of Service Here

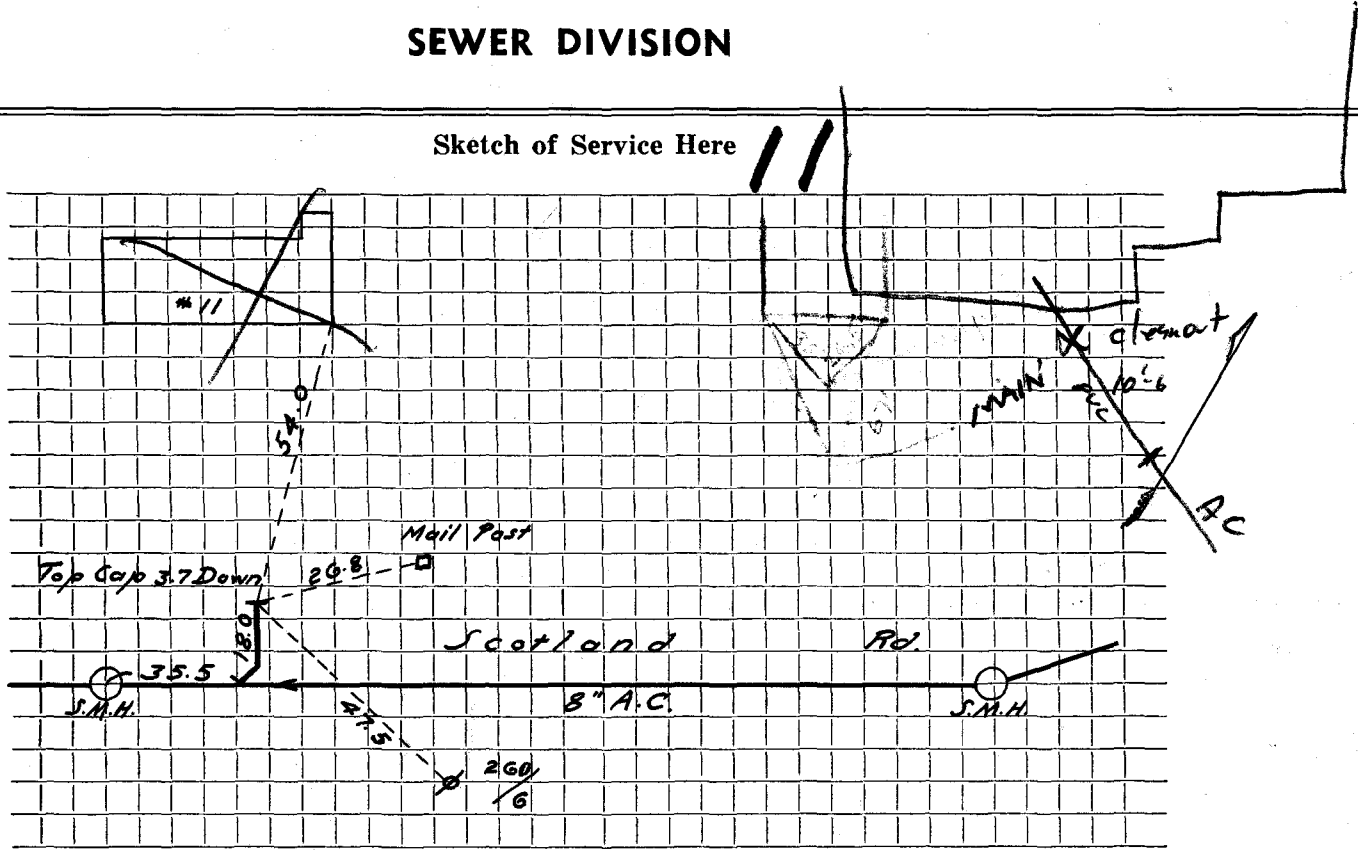

Connection made in Street. Work completed

Remarks:
.....
.....