

Name Lewis R. Aronin

Service No. 212

Address 12 Scotland Road

12 Scotland Road

Location

Kind of Pipe

Size 6"

Size of Main 8"

~~Repair - Renewal~~ New Service

W.C. # 8362

Location Comm 5-18-64

Date	Material	Amount	Total	Date	Amount
0/-/63	17.5' 6" A.C. installed by contractor @6.00 per foot	105 00		12-4-63 6-26-64	300 00 47 09 <u>347 09</u>
	BILL WHEN CONNECTED				
1-6-64	Labor 80.73				
4-17-64	" 37.56	118.29			
	10% O.H.	11.83	130.12		
	66' 6" Transite pipe @82		54.12		
	1 11 $\frac{1}{4}$ " ¹⁰ Transite bend		4.09		
	1 11 $\frac{1}{4}$ " ¹⁰ Transite Elbow		2.35		
	1 6 x 6 Transite "Y"		4.09		
	1 Duplex Adapter		1.62		
	5 yds. Loam @3.00		15.00		
	Lime & Fertilizer		1.20		
	3 hrs. Trucking @3.00		9.00		
	1 hr. Pump @1.00		1.00		
	3 hrs. Town Shovel @6.50		19.50		
			<u>347.09</u>		


13-1-64

DATE _____

TOWN OF LEXINGTON — BOARD OF PUBLIC WORKS

SEWER DIVISION

Sketch of Service Here **12**

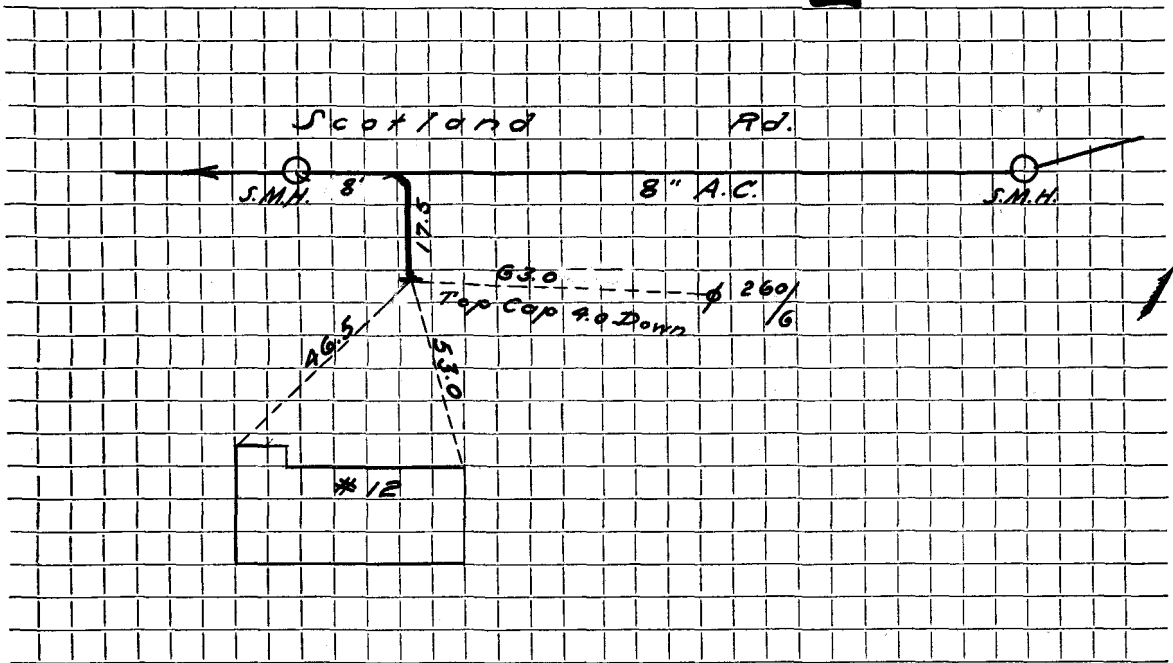

Connection made in Street. Work completed

Remarks:
.....
.....