

Name Richard S. Burwen

Service No. 7

Address 14 Scotland Road

14 Scotland Road

Location

Kind of Pipe

Size 6"

Size of Main 8"

~~Repair or Renewal~~ - New Service

WO # 8539

Location Comm 5-18-64


Date	Material	Amount	Total	Date	Amount
10/-/63	25.0' 6" A.C. installed by contractor @6.00 per foot	150 00		1-24-64 6-1-64	400 00 100 22 <u>500 22</u>
	BILL WHEN CONNECTED				
3-2-64	Labor 100.00				
4-13-64	" 57.39	157.39			
	10% O.H.	15.74	173.13		
104'	6" Transite pipe @.82		85.23		
2	11 $\frac{1}{2}$ " Transite Bends @4.09		8.18		
1	22 $\frac{1}{2}$ " Transite Elbow		2.35		
1	22 $\frac{1}{2}$ " Transite Bend		4.09		
1	6 x 6 Transite "Y"		4.09		
1	bag cement		1.55		
5 $\frac{1}{2}$	ton Stone @1.50		8.25		
7	yards Loam @3.00		21.00		
$\frac{1}{2}$	bag lime		.30		
$\frac{1}{2}$	bag Turf Builder		2.00		
	Cesspool Pumped		40.00		
			500.22		

DATE \_\_\_\_\_

TOWN OF LEXINGTON — BOARD OF PUBLIC WORKS

SEWER DIVISION

Sketch of Service Here **14**

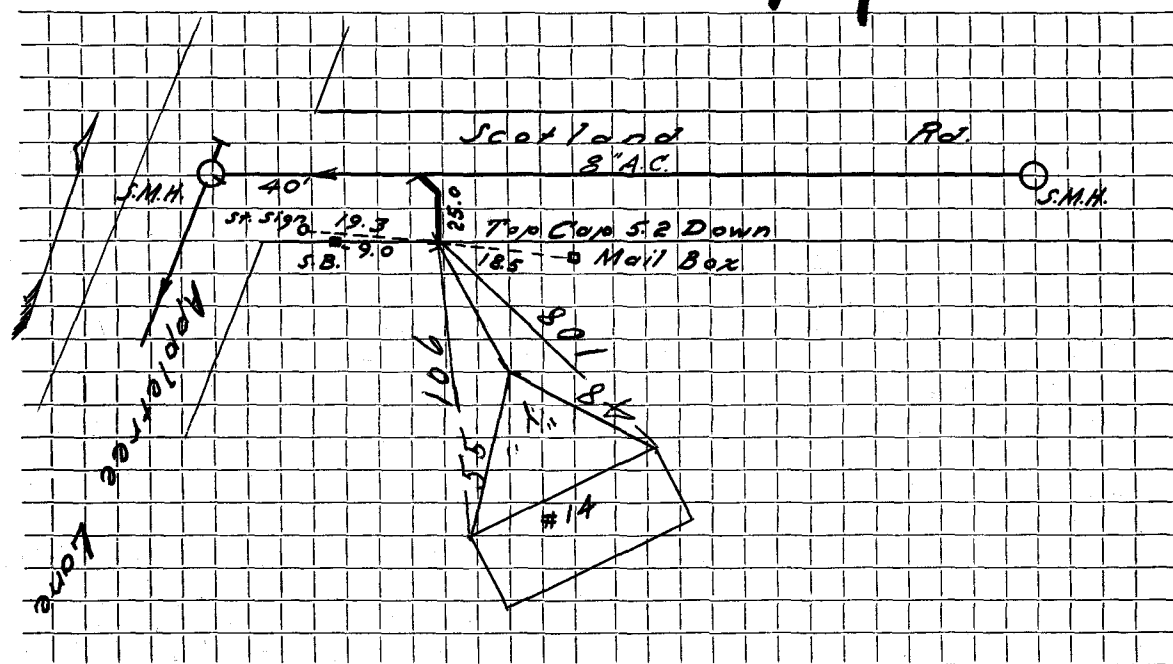

Connection made in ..... Street. Work completed .....

Remarks: .....  
.....  
.....