


DATE 12-12-01

TOWN OF LEXINGTON — BOARD OF PUBLIC WORKS
SEWER DIVISION

Sketch of Service Here

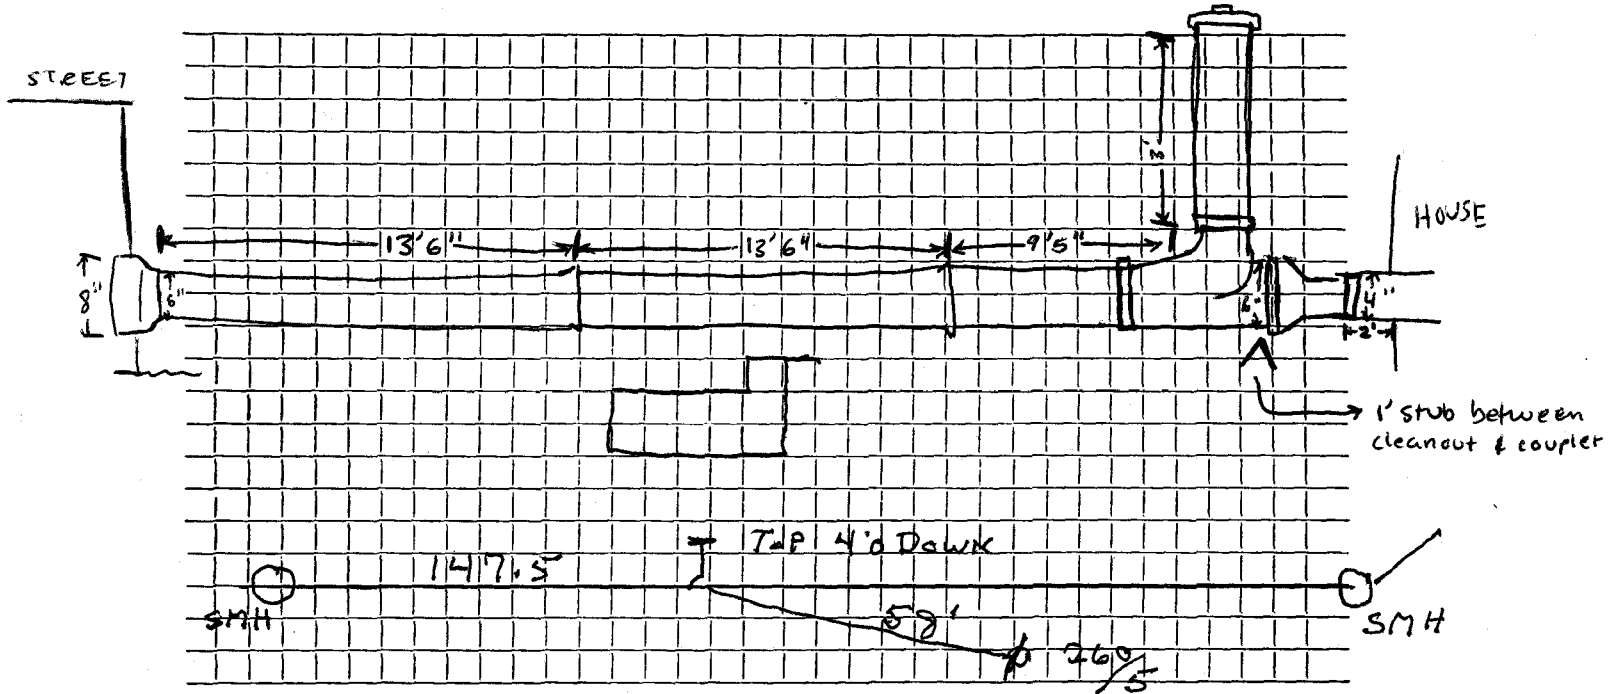

Connection made in SCOTTLAND Rd Street. Work completed

Remarks: Goes straight out from house with clean out 1'6" from house

INSTALLED BY DERILCO