


DATE _____

TOWN OF LEXINGTON — BOARD OF PUBLIC WORKS

SEWER DIVISION

Sketch of Service Here

14

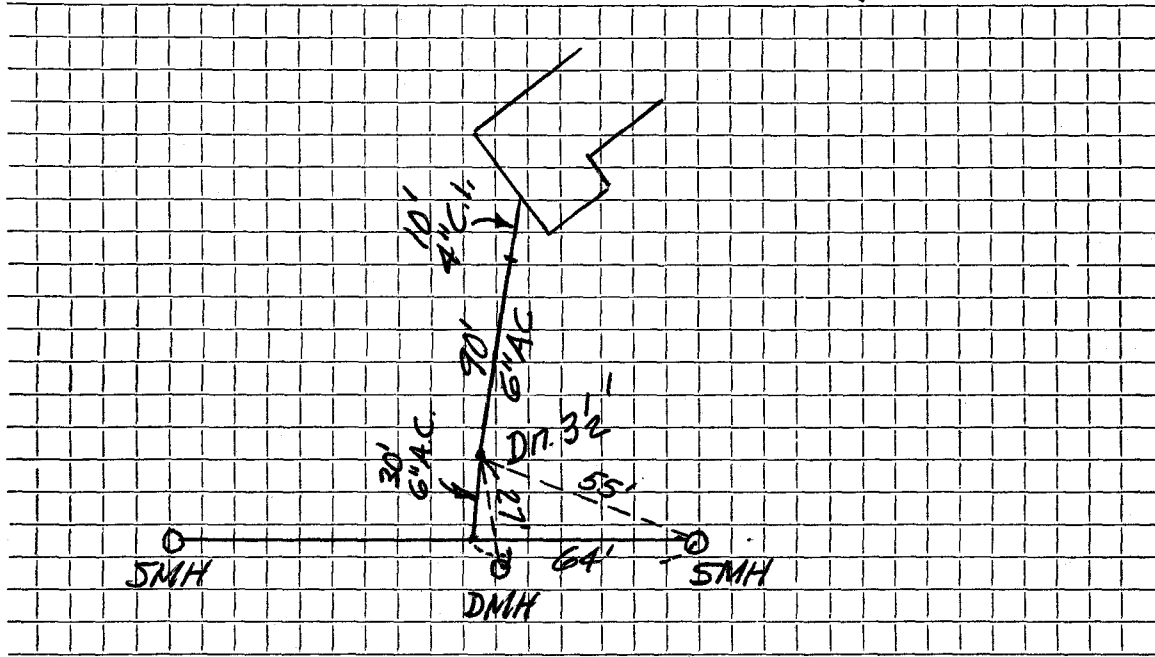

#14
SCOTT RD.

Connection made in Scott Rd. Street. Work completed

Remarks: